

YA 200
 P 2005
 7-17-80

MISSISSIPPI DEPARTMENT OF NATURAL RESOURCES
 Bureau of Land and Water Resources
 Southport Mall
 P.O. Box 10631
 Jackson, Mississippi 39209
WATER WELL DRILLERS LOG

July 17 1980 E.M. "Bud" CRESSWELL YA 200
 date well completed firm name county well located

LANDOWNER:
 Barrier Bros.
 Yazoo City, Mo.
 (mailing address)

description of formations encountered	from	to
	Clay Sand-graup	0 30

WELL LOCATION:
 sec. 14 T. 19 N R. 4 W
 4 miles NW of Satchita
 (distance) (direction) (nearest town)

WELL PURPOSE: Home
 (home, irrigation, municipal, industrial)

- WELL COMPLETION DATA:
- (1) diameter (inches) 2
 - (2) total depth (feet) 120
 - (3) static water level (feet) 20 below top of ground.
 - (4) casing PVC, 110,
 (material) (depth)
2 if telescope see back.
 (size)
 - (5) screen 10, 110
 (length) (depth to top)
2, PVC
 (size) (material)
 - (6) pump 1/2, 10
 (HP) (yield gpm)
0
 (type power)
 - (7) electric log No
 (yes or no)
 - (organization running log)


(8) how well bottom plugged
 Sand-shrub

DRILLERS REMARKS:

DEPT. OF NATURAL RESOURCES
 BUREAU OF LAND & WATER RESOURCES
 RECEIVED
 JUL 20 1980

If well telescopes please sketch and show depths.

GROUND LEVEL

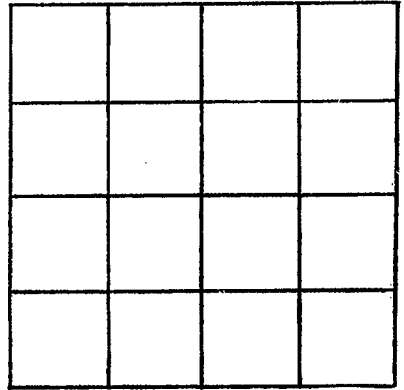

SECTION _____

Please indicate well location X.

ADDITIONAL INFORMATION

If more than one screen,
show locations of each on sketch.