

MISSISSIPPI DEPARTMENT OF NATURAL RESOURCES

Bureau of Land and Water Resources

Southport Mall

P.O. Box 10631

Jackson, Mississippi 39209

WATER WELL DRILLERS LOG

Yazoo
P
10-17-80

Oct. 7, 1980 E.M. "Bud" Cresswell Yazoo
 date well completed firm name county well located

LANDOWNER:
Neal Gray
Satartia, Miss.
 (mailing address)

description of formations encountered	from	to
<u>gravel</u>	<u>0</u>	<u>60</u>
<u>Sand-gravel</u>	<u>60</u>	<u>120</u>

WELL LOCATION:
 sec. 1 T. 10 N. R. 4
5 miles West of Satartia
 (distance) (direction) (nearest town)

WELL PURPOSE: home
 (home, irrigation, municipal, industrial)

WELL COMPLETION DATA:

- (1) diameter (inches) 2
- (2) total depth (feet) 120
- (3) static water level (feet) 20 below above top of ground
- (4) casing PVC 100
 (material) (depth)
- 2 If telescope see back.
 (size)
- (5) screen 20 100
 (length) (depth to top)
- 2 PVC
 (size) (material)
- (6) pump 1 10
 (HP) (yield gpm)
- (type power)
- (7) electric log NO-
 (yes or no)
- _____
 (organization running log)


	RECEIVED OCT 17 1980 DEPT. OF NATURAL RESOURCES BUREAU OF LAND & WATER RESOURCES	

How well bottom plugged back wash valve

DRILLERS REMARKS:

If well telescopes please
sketch and show depths.

GROUND LEVEL

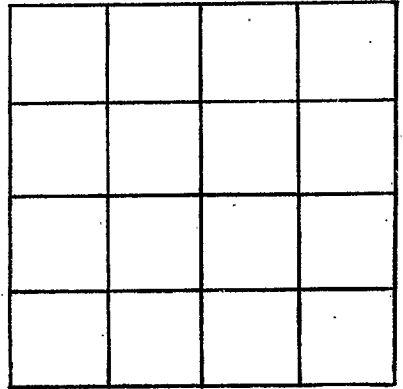

SECTION _____

Please indicate well location X.

ADDITIONAL INFORMATION

If more than one screen,
show locations of each on sketch.