

MISSISSIPPI DEPARTMENT OF NATURAL RESOURCES

Bureau of Land and Water Resources

Southport Mall

P.O. Box 10631

Jackson, Mississippi 39209

WATER WELL DRILLERS LOG

YAZOO  
P 2009  
5/7/81

May 7 1981 L.M. "Bud" Cresswell YAZOO  
date well completed firm name county well located


LANDOWNER:	description of formations encountered	from	to
Inez Davis Holly Bluff Ms. (mailing address)	Clay Sand Gravel Clay Sand	0 30 145 480	30 145 480 560
<b>WELL LOCATION:</b> sec. 18 T. 10 N R. 4 W 7 miles West of SATARTIA (distance) (direction) (nearest town)			
<b>WELL PURPOSE:</b> Home (home, irrigation, municipal, industrial)			
<b>WELL COMPLETION DATA:</b>			
(1) diameter (inches) 4			
(2) total depth (feet) 560			
(3) static water level (feet) 11 below top of ground.			
(4) casing Steel, 540 (material), (depth) 4 (size) if telescope see back.			
(5) screen 20, 540 (length), (depth to top)			
(6) pump 1, 20 (HP), (yield gpm) Stainless (material)			
(7) electric log No (yes or no)			
(organization running log)			
(8) How well bottom plugged back wash valve			
DRILLERS REMARKS:			

DEPT. OF NATURAL RESOURCES  
BUREAU OF LAND & WATER RESOURCES

MAY 19 1981  
RECEIVED

If well telescopes please  
sketch and show depths.

GROUND LEVEL

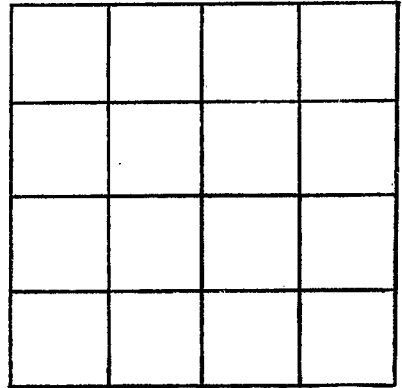

SECTION \_\_\_\_\_

Please indicate well location X.

ADDITIONAL INFORMATION

If more than one screen,  
show locations of each on sketch.