

MISSISSIPPI DEPARTMENT OF NATURAL RESOURCES

Bureau of Land and Water Resources

Southport Mall

P.O. Box 10631

Jackson, Mississippi 39209

WATER WELL DRILLERS LOG

Yazoo  
PO 2007  
9-15-81

Sept. 15 1981 E.M. Bud "Cresswell" Yazoo  
 date well completed firm name county well located

LANDOWNER: Bobby Ragland  
SARATIA, MS.  
 (mailing address)

description of formations encountered	from	to
<u>Gumbo</u>	<u>0</u>	<u>30</u>
<u>Sand-gravel</u>	<u>30</u>	<u>100</u>

WELL LOCATION:  
 sec. 28 T 10 N R 4  
5 miles West of SARATIA  
 (distance) (direction) (nearest town)

WELL PURPOSE: Home  
 (home, irrigation, municipal, industrial)

- WELL COMPLETION DATA:
- (1) diameter (inches) 2
  - (2) total depth (feet) 100
  - (3) static water level (feet) 22 below top of ground.
  - (4) casing PVC 90  
 (material) (depth)  
2 if telescope see back.  
 (size)
  - (5) screen 10 90  
 (length) (depth to top)  
2 PVC  
 (size) (material)
  - (6) pump 1 10  
 (HP) (yield gpm)  
 (type power)
  - (7) electric log No  
 (yes or no)  
 (organization running log)

(8) how well bottom plugged  
Sand Shale

DRILLERS REMARKS:


DEPT. OF NATURAL RESOURCES  
 BUREAU OF LAND & WATER RESOURCES

OCT 13 1981

RECEIVED

If well telescopes please  
sketch and show depths.

GROUND LEVEL

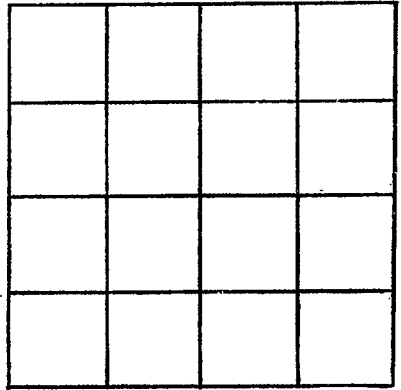

SECTION \_\_\_\_\_

Please indicate well location X.

ADDITIONAL INFORMATION

If more than one screen,  
show locations of each on sketch.