

MISSISSIPPI DEPARTMENT OF NATURAL RESOURCES

Bureau of Land and Water Resources

Southport Mall

P.O. Box 10631

Jackson, Mississippi 39209

WATER WELL DRILLERS LOG

Handwritten notes in a box: C/goo, P 200

Number 9 1982 E.M. Sudd (RESSWELL) Yazoo  
Date well completed firm name county well located

LANDOWNER: Mr. Warren Davis Jr.  
Spartan, Mo.  
(mailing address)

description of formations encountered

Clay  
sand

from to

0 80  
80 90

WELL LOCATION:

sec. 33 T. 10 N R. 4 E  
3 miles SW of Spartan  
(distance) (direction) (nearest town)

WELL PURPOSE: Home  
(home, irrigation, municipal, industrial)

WELL COMPLETION DATA:

- (1) diameter (inches) 2
- (2) total depth (feet) 90
- (3) static water level (feet) 18 below top of ground.
- (4) casing PVC 80 (material), (depth)
- (size) 2 if telescope see back.
- (5) screen 10 80 (length), (depth to top)
- (size) 2, PVC (material)
- (6) pump 1 10 (HP), (yield gpm)
- (type power)
- (7) electric log No (yes or no)

(organization running log)

(8) how well bottom plugged  
Back wash valve

DRILLERS REMARKS:


DEPT. OF NATURAL RESOURCES  
BUREAU OF LAND & WATER RESOURCES

MAR 26 1982

RECEIVED

If well telescopes please  
sketch and show depths.

GROUND LEVEL

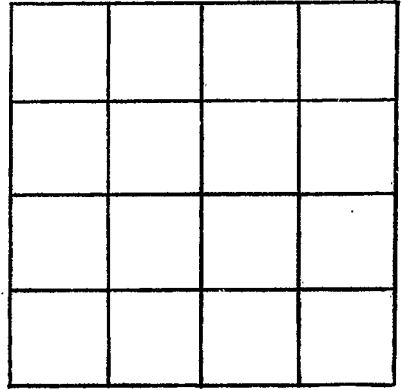

SECTION \_\_\_\_\_

Please indicate well location X.

ADDITIONAL INFORMATION

If more than one screen,  
show locations of each on sketch.