

MISSISSIPPI DEPARTMENT OF NATURAL RESOURCES

Bureau of Land and Water Resources

Southport Mall

P.O. Box 10631

Jackson, Mississippi 39209

WATER WELL DRILLERS LOG

Yazoo  
P  
2012

April 5 1984 E. M. 'Bud' Cresswell Yazoo  
 (date well completed) (firm name) (county well located)

LANDOWNER:  
Kenny Roberts  
Yazoo City, MS.  
 (mailing address)

description of formations encountered	from	to
<u>Clay</u>	<u>0</u>	<u>30</u>
<u>sandy-gravel</u>	<u>30</u>	<u>120</u>

WELL LOCATION:  
 sec 20 T 10 N R 4  
5 miles West of De Witt  
 (distance) (direction) (nearest town)

WELL PURPOSE: Farm  
 (home, irrigation, municipal, industrial)

WELL COMPLETION DATA:

(1) diameter (inches) 4

(2) total depth (feet) 120

(3) static water level (feet) 20 below top of ground.

(4) casing PVC 110  
 (material) (depth)

4  
 (size) if telescope see back.

(5) screen 10 110  
 (length) (depth to top)

4 PVC  
 (size) (material)

(6) pump 1 25  
 (HP) (yield gpm)

(type power)

(7) electric log no  
 (yes or no)

(organization running log)

(8) how well bottom plugged  
back with valve

DRILLERS REMARKS:


DEPT. OF NATURAL RESOURCES  
 BUREAU OF LAND & WATER RESOURCES

APR 16 1984

RECEIVED

If well telescopes please sketch and show depths.

GROUND LEVEL

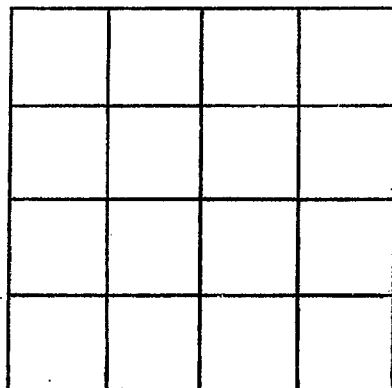

SECTION \_\_\_\_\_

Please indicate well location X.

ADDITIONAL INFORMATION

If more than one screen,  
show locations of each on sketch.