

MISSISSIPPI DEPARTMENT OF NATURAL RESOURCES

Bureau of Land and Water Resources

Southport Mall

P.O. Box 10631

Jackson, Mississippi 39209

WATER WELL DRILLERS LOG

Yazoo  
P  
2013

Nov. 12 1984 E.M. 'Bud' Cresswell Yazoo  
date well completed firm name county well located

LANDOWNER:	description of formations encountered	from	to
<u>Kevin Coleman</u> <u>Yazoo City, MS.</u> (mailing address)			
<b>WELL LOCATION:</b>			
sec. <u>28</u> T. <u>10</u> N. R. <u>4</u> W.			
<u>3</u> miles <u>West</u> of <u>SARTIA</u> (distance) (direction) (nearest town)			
<b>WELL PURPOSE:</b> <u>FARM</u> (home, irrigation, municipal, industrial)			
<b>WELL COMPLETION DATA:</b>			
(1) diameter (inches) <u>4</u>			
(2) total depth (feet) <u>120</u>			
(3) static water level (feet) <u>20</u> below top of ground.			
(4) casing <u>PVC</u> <u>100</u> (material) (depth)			
<u>4</u> if telescope see back. (size)			
(5) screen <u>20</u> <u>100</u> (length) (depth to top)			
<u>4</u> <u>PVC</u> (size) (material)			
(6) pump <u>1</u> <u>25</u> (HP) (yield gpm)			
<u>0</u> (type power)			
(7) electric log <u>No</u> (yes or no)			
<u>—</u> (organization running log)			
(8) how well bottom plugged <u>back wash valve</u>			
<b>DRILLERS REMARKS:</b>			


DEPT. OF NATURAL RESOURCES  
BUREAU OF LAND & WATER RESOURCES

DEC - 7 1984

RECEIVED

If well telescopes please sketch and show depths.

GROUND LEVEL

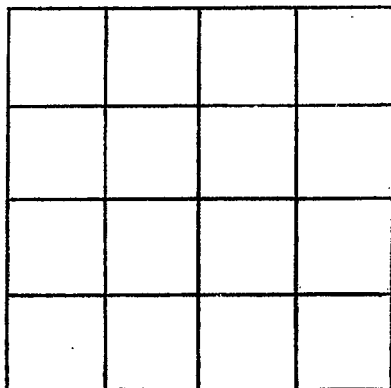

SECTION \_\_\_\_\_

Please indicate well location X.

ADDITIONAL INFORMATION

If more than one screen, show locations of each on sketch.