

MISSISSIPPI DEPARTMENT OF NATURAL RESOURCES
 Bureau of Land and Water Resources
 Southport Mall
 P.O. Box 10631
 Jackson, Mississippi 39209
WATER WELL DRILLERS LOG

YAZOO
Paris

5-3-86 19 IRRIGATION EQUIPMENT YAZOO
 date well completed firm name county well located

LANDOWNER: TRAVELERS
INSURANCE 916 Hwy 82 West.
Greenwood, MS
 (mailing address)


description of formations encountered	from	to
clay	0	10
FINE SAND	10	55
COARSE SAND/pea gravel	55	115

WELL LOCATION:
 sec. 2 T 10 N R 5 E
7 miles South of Holly Bluff
 (distance) (direction) (nearest town)

WELL PURPOSE: pivot
 (home, irrigation, municipal, industrial)

- WELL COMPLETION DATA:
- (1) diameter (inches) 16
 - (2) total depth (feet) 115
 - (3) static water level (feet) 28 below above top of ground.
 - (4) casing steel, 75'
 (material) (depth)
16" if telescope see back.
 (size)
 - (5) screen 40', 75'
 (length) (depth to top)
16", STEEL
 (size) (material)
 - (6) pump 200 2200
 (HP) (yield gpm)
Diesel
 (type power)
 - (7) electric log NO
 (yes or no)
 (organization running log)
 - (8) how well bottom plugged steel plate

DRILLERS REMARKS: Temp. Permit
#86122MG501

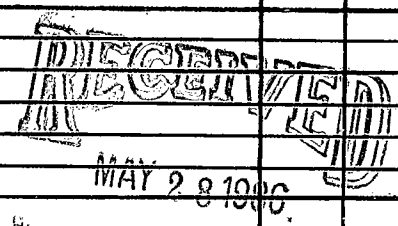

Department of Natural Resources
 Bureau of Land and Water Resources

