

MISSISSIPPI DEPARTMENT OF NATURAL RESOURCES

Bureau of Land and Water Resources

Southport Mall

P.O. Box 10631

Jackson, Mississippi 39209

WATER WELL DRILLERS LOG

YAZOO
 POOL

June 19 1986 E.M. Bud CRESSWELL YAZOO
 date well completed firm name county well located


LANDOWNER:
 WARREN DAVIS JR.
 YAZOO CITY, MS. 39194
 (mailing address)

description of formations encountered	from	to
	SURFACE	0
SAND-GRAVEL	40	90
Blue CLAY	90	480
SANDY SHALE	480	580
Shale	580	640
SAND	640	740

WELL LOCATION:
 sec 34 T 10 N R 4 W
 2 miles South of SATARTIA
 (distance) (direction) (nearest town)

WELL PURPOSE: Home
 (home, irrigation, municipal, industrial)

- WELL COMPLETION DATA:
- (1) diameter (inches) 4
 - (2) total depth (feet) 740
 - (3) static water level (feet) 6 below surface top of ground.
 - (4) casing PVC, 700 (material), (depth)
 4 (size) If telescope see back.
 - (5) screen 40, 700 (length), (depth to top)
 4, PVC (size), (material)
 - (6) pump 1 (HP), 10 (yield gpm)
 (type power)
 - (7) electric log No (yes or no)
 (organization running log)
 - (8) How well bottom plugged?
 Backwash

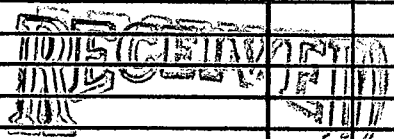


JUN 25 1986

Department of Natural Resources
 Bureau of Land & Water Resources

DRILLERS REMARKS:

If well telescopes please sketch and show depths.

GROUND LEVEL

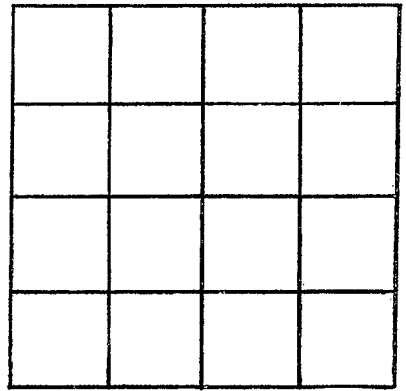

SECTION _____

Please indicate well location X.

ADDITIONAL INFORMATION

If more than one screen,
show locations of each on sketch.