

MISSISSIPPI DEPARTMENT OF NATURAL RESOURCES

Bureau of Land and Water Resources

Southport Mall

P.O. Box 10631

Jackson, Mississippi 39209

WATER WELL DRILLERS LOG

4A200
P207

Aug. 5 1987 E.M. Bud Russell 4A200
date well completed firm name county well located

LANDOWNER:	description of formations encountered	from	to
<u>P.C. McTavis</u>			
<u>SARATIA, MS. 39162</u> (mailing address)	<u>gluab</u>	<u>0</u>	<u>90</u>
	<u>sand</u>	<u>90</u>	<u>110</u>
	<u>Yeo Clay</u>	<u>110</u>	<u>320</u>
	<u>Woodbury Branch</u>	<u>320</u>	<u>350</u>
	<u>Sandy Shell</u>	<u>350</u>	<u>380</u>
	<u>lime sand</u>	<u>380</u>	<u>440</u>
	<u>sand</u>	<u>440</u>	<u>550</u>
WELL LOCATION: sec. <u>25</u> T <u>10</u> N R <u>4</u> W <u>1</u> miles (distance) <u>West</u> (direction) of <u>Saratia</u> (nearest town)			
WELL PURPOSE: <u>Home</u> (home, irrigation, municipal, industrial)			
WELL COMPLETION DATA: (1) diameter (inches) <u>4</u> (2) total depth (feet) <u>550</u> (3) static water level (feet) <u>6</u> below top of ground. (4) casing <u>PVC</u> <u>570</u> (material) (depth) <u>4</u> (size) if telescope see back. (5) screen <u>40</u> <u>570</u> (length) (depth to top) <u>4</u> (size) <u>PVC</u> (material) (6) pump <u>1</u> <u>20</u> (HP) (yield gpm) (type power) (7) electric log <u>no</u> (yes or no) (organization running log) (8) how well bottom plugged <u>Sand shell</u>			

RECEIVED


AUG 26 1987

Department of Natural Resources
Bureau of Land & Water Resources

DRILLERS REMARKS:

If well telescopes please sketch and show depths.

GROUND LEVEL

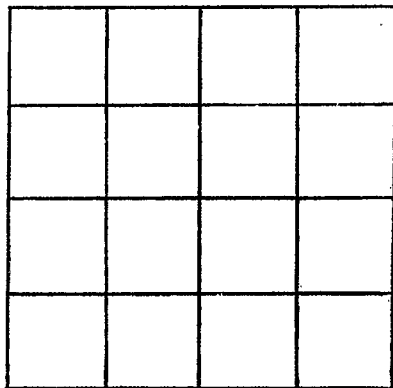

SECTION _____

Please indicate well location X.

ADDITIONAL INFORMATION

If more than one screen,
show locations of each on sketch.