

**MISSISSIPPI DEPARTMENT OF ENVIRONMENTAL QUALITY**

Office of Land and Water Resources

P. O. Box 10631  
Jackson, MS 39289-0631

COUNTY WELL LOCATED <b>Yazoo</b>	
WELL NUMBER <b>F 2022</b>	CODED
DATE WELL COMPLETED <b>Nov. 14, 1996</b>	

PERMIT NUMBER
NAME OF DRILLING FIRM <b>K.M. Bud Cresswell</b>
<b>Bentonla, MS 39040</b>

**WATER WELL DRILLERS LOG**

NAME & MAILING ADDRESS OF LANDOWNER <b>Billy MARTIN</b> <b>FLORA, MS-</b>		
---	--	--

<b>PUMP DATA</b>		
PUMP TYPE (Circle One): Submersible, Turbine, Jet, Flowing Well, Other (Describe) <b>No Pump</b>		
POWER TYPE (Circle One): Electric, Tractor, Diesel, Gasoline, Butane, Other (Describe) _____ H/P _____		
Pump Capacity (GPM)	No. of Stages	Setting Depth  <b>FT.</b>

WELL LOCATION:	SEC	TOWNSHIP	RANGE
	<b>27</b>	<b>10</b>	<b>N 5 W</b>

<b>PUMP TEST</b>	
Well yielded <b>30</b> GPM with a drawdown of <b>10</b> ft. after <b>1/2</b> hours of pumping	

DISTANCE	DIRECTION	NEAREST TOWN
<b>1/4</b> Miles	<b>South</b>	<b>SARTORIA</b>

OTHER LANDMARK
WELL PURPOSE: Home, Irrigation, Municipal, Industrial, Fish Pond, etc. <b>Deer Camp-</b>

<b>WELL DATA</b>		
Well Depth <b>70</b>	Casing Diameter (In.) <b>4</b>	Casing Length (Ft.) <b>60</b>
Type of Casing <b>PVC</b>	Hole Depth <b>70</b>	Depth to Static Water Level <b>20</b>

<b>LOG DATA</b>	
TYPE OF LOG RUN (Circle One): Electric, Gamma Ray, Density, Sonic, Neutron, Other (Describe) <b>No Log Run</b>	
Name of Organization Running Log	

TYPE OF COMPLETION: (Circle One or More): Gravel Packed, Underreamed, Telescoped, <b>Natural Development</b> , Open Hole, Other			
---	--	--	--

<b>GEOLOGIC DATA (Office Use Only)</b>			
Surface Elev.	Geologic Unit	Unit Thickness	Depth to Top
Subs. SWL	Date	Analysis	Aquifer Test

WELL GROUTED TO A DEPTH OF <b>25</b> FEET Type Grout (circle one): Cement, Bentonite, or Mix
---

Driller's Remarks
Top of Lap Pipe or Reduction in Casing <b>FEET</b>
IF TELESCOPED OR MORE THAN ONE SCREEN USE BACK PAGE

<b>SCREEN DATA</b>		
Diameter - Inches <b>4</b>	Length - Feet <b>10</b>	Slot Size - Inches <b>.013</b>
Screen Type <b>PVC</b>	Depth to Bottom - Feet <b>70</b>	

DESCRIPTION OF FORMATIONS ENCOUNTERED	FROM	TO
<b>FLUMBO SAND</b>	<b>0</b>	<b>30</b>
	<b>30</b>	<b>70</b>


NOV 21 1996

Dept. of Environmental Quality  
Office of Land & Water Resources

IF MORE SPACE IS NEEDED, USE BACK

If well telescopes please  
sketch and show depths.

GROUND LEVEL

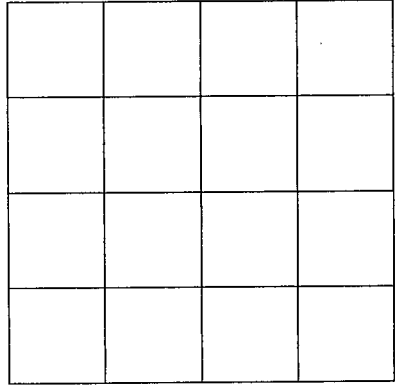

SECTION \_\_\_\_\_

Please indicate well location X.

ADDITIONAL INFORMATION

If more than one screen,  
show location of each on sketch.