

YAZOO
Q7
9-1-72

MISSISSIPPI
BOARD OF WATER COMMISSIONERS
416 North State Street
Jackson, Mississippi 39201

CODED

WATER WELL DRILLERS LOG

Sept-1 1972 E.M. "Bud" Cresswell Yazoo
date well completed firm name county well located

LANDOWNER:
Don S. Miller
Vicksburg, Miss.
(mailing address)

| description of formations encountered | from | to |
|---------------------------------------|------|-----|
| Clay Sand | 0 | 395 |
| | 395 | 560 |

WELL LOCATION:
sec 31 T 10 N R 3 W
at Satastia
(distance) (direction) (nearest town)

WELL PURPOSE: Domestic
(home, irrigation, municipal, industrial)

WELL COMPLETION DATA:

(1) diameter (inches) 4

(2) total depth (feet) 560

(3) static water level (feet) 12 below above top of ground.

(4) casing steel 540 (material) (depth)
4 (size) if telescope see back.

(5) screen 20 540 (length) (depth to top)
2 Stainless (size) (material)

(6) pump 1 20 (HP) (yield gpm)
0 (type power)

(7) electric log No (yes or no)
0 (organization running log)

(8) how well bottom plugged
Steel plug

CODED


SEP 7 1972

DRILLERS REMARKS:

MISSISSIPPI BOARD OF WATER COMMISSIONERS

If well telescopes please
sketch and show depths.

GROUND LEVEL

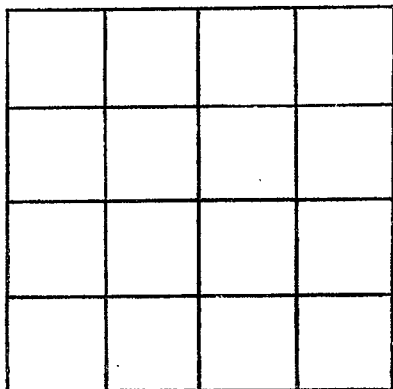

SECTION _____

Please indicate well location X.

ADDITIONAL INFORMATION

If more than one screen,
show locations of each on sketch.