

CODED

MISSISSIPPI
 BOARD OF WATER COMMISSIONERS
 416 North State Street
 Jackson, Mississippi 39201

WATER WELL DRILLERS LOG

YAZOO
 Q8
 8-18-72

Aug. 18 1972 E.M. "Bud" Cresswell YAZOO
 date well completed firm name county well located

LANDOWNER:
 TOWN OF SATARTIA
 SATARTIA, Miss.
 (mailing address)

description of formations encountered	from	to
gumbo	0	25
hard gravel	25	115
clay	115	385
sand	385	560

WELL LOCATION:
 sec 31 T 10 N R 3 E
 (distance) miles _____ of _____ (direction) (nearest town)

WELL PURPOSE: Municipal
 (home, irrigation, municipal, industrial)

WELL COMPLETION DATA:

(1) diameter (inches) 4

(2) total depth (feet) 560

(3) static water level (feet) 0 below above top of ground.

(4) casing Steel 520
 (material) (depth)

4 if telescope see back.
 (size)

(5) screen 40 520
 (length) (depth to top)

2" stainless
 (size) (material)

(6) pump 2 45
 (HP) (yield gpm)

0
 (type power)

(7) electric log No
 (yes or no)

0
 (organization running log)

CODED


(8) how well bottom plugged
steel plug

DRILLERS REMARKS:

SEP 7 1972
 MISSISSIPPI
 WATER BOARD

If well telescopes please sketch and show depths.

GROUND LEVEL

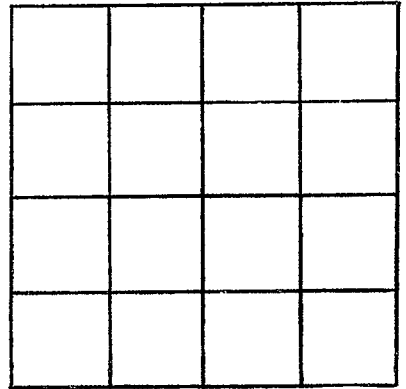

SECTION _____

Please indicate well location X.

ADDITIONAL INFORMATION

If more than one screen,
show locations of each on sketch.