

YAZOO Co.  
 Q9  
 Log # 249

MISSISSIPPI  
 BOARD OF WATER COMMISSIONERS  
 416 North State Street  
 Jackson, Mississippi 39201

**CODED**

WATER WELL DRILLERS LOG

March 3 1973 E.M. "Bud" Cresswell Yazoo  
 date well completed firm name county well located

LANDOWNER:  
 F. A. Moody  
 Yazoo City, Miss.  
 (mailing address)

WELL LOCATION:  
 sec. 10 T. 10 N R. 3  
 5 miles N of Starlet's  
 (distance) (direction) (nearest town)

WELL PURPOSE: home  
 (home, irrigation, municipal, industrial)

WELL COMPLETION DATA:

- (1) diameter (inches) 4 X 2
- (2) total depth (feet) 950
- (3) static water level (feet) 11 below top of ground.
- (4) casing steel, 930 (material) (depth)  
 2 (size) if telescope see back.
- (5) screen 20 1/4, 930 (length) (depth to top)  
 2, stainless (size) (material)
- (6) pump 3/4, 20 (HP) (yield gpm)  
 0 (type power)
- (7) electric log yes (yes or no)  
 United States Leasing (organization running log)
- (8) how well bottom plugged steel plug

description of formations encountered	from	to
Clay	0	185
sand	185	205
Clay	205	240
sandy-shale	240	310
sand & sh. shale	310	420
shale	420	630
sand	630	740
shale	740	790
sand	790	850
shale	850	890
sand	890	950


**CODED**

DRILLERS REMARKS:

MAR 7 1973

If well telescopes please sketch and show depths.

GROUND LEVEL

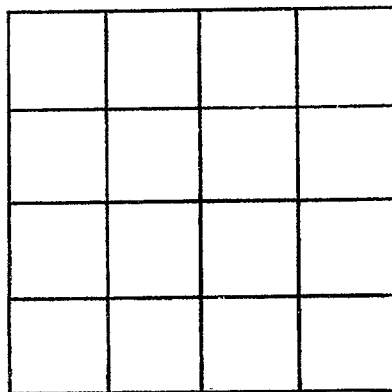

SECTION \_\_\_\_\_

Please indicate well location X.

ADDITIONAL INFORMATION

If more than one screen, show locations of each on sketch.