

32-44-26
90-32-43

Coded



MISSISSIPPI
BOARD OF WATER COMMISSIONERS
416 North State Street
Jackson, Mississippi 39201
WATER WELL DRILLERS LOG

Yazoo
Q10
8-67

Aug. 9 1967 Dyer Well & Irr. Ser. Yazoo
date well completed firm name county well located

LANDOWNER: J. J. Peaster Jr.

description of fomations encountered

from to

R. R. Yazoo City, Miss.

Clay	0	13
Fine sand and blue clay	13	43
Med. sand	43	73
Fine sand	73	83
Cr. sand & gravel	83	96

(mailing address)

WELL LOCATION:


sec 7 T 10 N R 3 E
10 miles S.W. of YAZOO CITY
(distance) (diréction) (nearest town)

WELL PURPOSE: Catfish
(home, irrigation, municipal, industrial)

WELL COMPLETION DATA:

- (1) diameter (inches) 16"
- (2) total depth (feet) 96'
- (3) static water level (feet) 19' below
top of ground.
- (4) casing Blk. Ir. 56'
(material) (depth)
 if telescope see back.
(size)
- (5) screen 49' , 56'
(length) (depth to top)
16" Blk. Ingot Ir.
(size) (material)
- (6) pump 60 3000
(HP) (yield gpm)
Diesel
(type power)
- (7) electric log No
(yes or no)

(organization running log)
- (8) how well bottom plugged Steel
Plate welded on bottom.

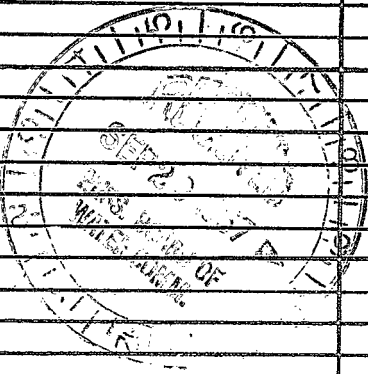


DRILLERS REMARKS:

8

If well telescopes please sketch and show depths.

GROUND LEVEL

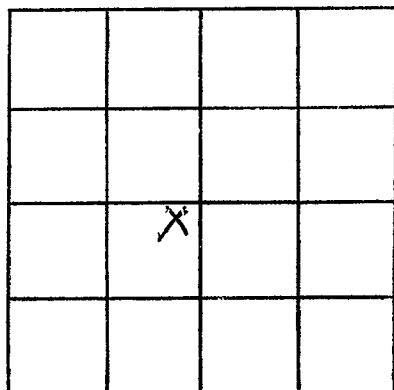

SECTION 7

Please indicate well location X.

ADDITIONAL INFORMATION

If more than one screen, show locations of each on sketch.