

MISSISSIPPI
BOARD OF WATER COMMISSIONERS
416 North State Street
Jackson, Mississippi 39201

CODED

WATER WELL DRILLERS LOG
DYER WELL & IRRIGATION SERVICE

* 3
Yazoo
Q 13
8-6-69
8-6-69

date well completed

firm name

county well located

LANDOWNER: John Reaster
Yazoo City Miss
(mailing address)

description of formations encountered

from to

4' clay	6' sand	3' Blue	0	13
Blue clay	5' Fine sand		13	23
			23	33
			33	43
5' Med.	5' Coarse		43	53
Coarse sand	Gravel		53	63
			63	73
			73	83
			83	93

WELL LOCATION:

sec. 7 T 10 N R 3 E
13 miles S of Y.C.
(distance) (direction) (nearest town)

WELL PURPOSE: FISH
(home, irrigation, municipal, industrial)

WELL COMPLETION DATA:

- (1) diameter (inches) 16"
- (2) total depth (feet) 93'
- (3) static water level (feet) 13 below top of ground.
- (4) casing BUR IR, 53 (material) (depth)
- (size) if telescope see back.
- (5) screen 40 53 (length) (depth to top)
- 16" BUR IR (size) (material)
- (6) pump 65 2,000 (HP) (yield gpm)
- Dieser (type power)
- (7) electric log no (yes or no)
- (organization running log)
- (8) how well bottom plugged Plate


OCT 6 - 1969

DRILLERS REMARKS:

MISS. BD. OF
WATER COM.

If well telescopes please sketch and show depths.

GROUND LEVEL

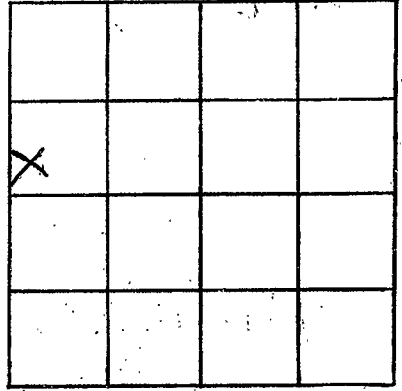

SECTION 7

Please indicate well location X.

ADDITIONAL INFORMATION

If more than one screen,
show locations of each on sketch.