

MISSISSIPPI
 BOARD OF WATER COMMISSIONERS
 416 North State Street
 Jackson, Mississippi 39201

Colwell

WATER WELL DRILLERS LOG

Yazoo Co
Q 14
1-15-70

1-15 1970 to Bud Cresswell Yazoo
 date well completed firm name county well located

LANDOWNER:

Harvey Williams

Tinsley, Miss-
 (mailing address)

description of formations encountered

from to

Clay
Sand-gravel

0 50
50 89

WELL LOCATION:

sec. 15 T 10 R 3 150
3 miles West of Tinsley
 (distance) (direction) (nearest town)

WELL PURPOSE: DOMESTIC
 (home, irrigation, municipal, industrial)

WELL COMPLETION DATA:

- (1) diameter (inches) 2
- (2) total depth (feet) 89
- (3) static water level (feet) 60 below above top of ground.
- (4) casing galv. 84
 (material) (depth)
2 if telescope see back.
 (size)
- (5) screen 5 84
 (length) (depth to top)
2 Stainless
 (size) (material)
- (6) pump _____ (HP) _____ (yield gpm)
 _____ (type power)
- (7) electric log _____ (yes or no)
 _____ (organization running log)
- (8) how well bottom plugged _____


APR 24 1970

DRILLERS REMARKS:

MISS. BD. OF
 WATER COMM.

If well telescopes please sketch and show depths.

GROUND LEVEL

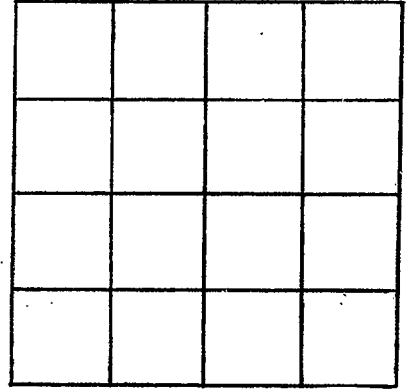

SECTION _____

Please indicate well location X.

ADDITIONAL INFORMATION

If more than one screen, show locations of each on sketch.