

YAZOO
 Q 16
 9-15-77

MISSISSIPPI
 BOARD OF WATER COMMISSIONERS
 416 North State Street
 Jackson, Mississippi 39201

CODED

WATER WELL DRILLERS LOG

9-15 1977 E.M. "Bud" CRESSWELL YAZOO
 date well completed firm name county well located

LANDOWNER:
 TOWN of SATARTIA
 SATARTIA, MS.
 (mailing address)

WELL LOCATION:
 sec. 31 T 10 N R 3 E W
 at SATARTIA
 miles of (distance) (direction) (nearest town)

description of formations encountered	from	to
Clay	0	30
Sand-gravel	30	110
clay	110	320
Sand - shells	320	350
Sand - shells	350	500
Sand	500	582

WELL PURPOSE: TOWN
 (home, irrigation, municipal, industrial)

WELL COMPLETION DATA:

(1) diameter (inches) 4

(2) total depth (feet) 582

(3) static water level (feet) 0 below above top of ground.

(4) casing Steel 540 (material) (depth)
 4 (size) If telescope see back.

(5) screen 40 540 (length) (depth to top)
 2 STAINLESS (size) (material)


(6) pump 2 50 (HP) (yield gpm)
 0 (type power)

(7) electric log No (yes or no)
 none (organization running log)

(8) how well bottom plugged
 steel plug

DRILLERS REMARKS:

CODED

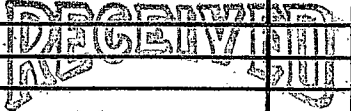


OCT 17 1977

MISS. BD. OF WATER COMM.

If well telescopes please
sketch and show depths.

GROUND LEVEL

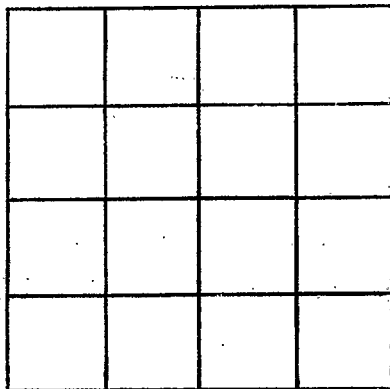

SECTION _____

Please indicate well location X.

ADDITIONAL INFORMATION

If more than one screen,
show locations of each on sketch.