

4200
Q 20
7-21-81

MISSISSIPPI
BOARD OF WATER COMMISSIONERS
416 North State Street
Jackson, Mississippi 39201

CODED

WATER WELL DRILLERS LOG

July 21 1981 E.M. Bud Cresswell 4200
date well completed firm name county well located

LANDOWNER:
Dudley Pillow
Jatartia, MS.
(mailing address)

WELL LOCATION:
sec. 4 T. 10 N R. 3 W
6 miles South of 4200
(distance) (direction) (nearest town)

WELL PURPOSE: FARM
(home, irrigation, municipal, industrial)

WELL COMPLETION DATA:
(1) diameter (inches) 4
(2) total depth (feet) 980
(3) static water level (feet) 24 below
top of ground.
(4) casing Steel 940
(material) (depth)
4 If telescope see back.
(size)
(5) screen 40 940
(length) (depth to top)
2" Stainless
(size) (material)
(6) pump 3 45
(HP) (yield gpm)
0
(type power)
(7) electric log No
(yes or no)
(organization running log)

description of formations encountered	from	to
Clay	0	40
Sand - graded	40	165
Clay	165	260
Sand - hard Clay	260	710
Shale - rock	710	820
Sand	820	980

(8) how well bottom plugged
back wash Valve

DRILLERS REMARKS:


DEPT. OF NATURAL RESOURCES
BUREAU OF LAND & WATER RESOURCES

AUG 14 1981

RECEIVED

If well telescopes please
sketch and show depths.

GROUND LEVEL

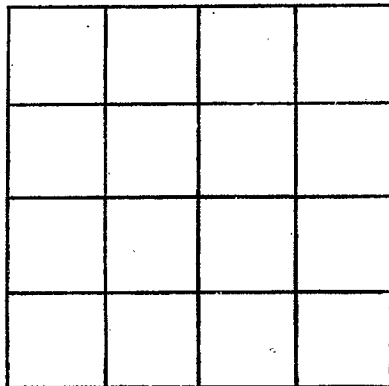

SECTION _____

Please indicate well location X.

ADDITIONAL INFORMATION

If more than one screen,
show locations of each on sketch.