

CODED

MISSISSIPPI
BOARD OF WATER COMMISSIONERS
416 North State Street
Jackson, Mississippi 39201

WATER WELL DRILLERS LOG

Yazoo
Q 26
12-10-67

Dec 10 19*67* *J H Barnes* *Yazoo*
date well completed firm name county well located

LANDOWNER: *Jessie A. Loundon*

SATARTIA
Miss

(mailing address)

description of formations encountered

from to

top soil
sand

0 20
80 90

WELL LOCATION:

sec. *20* T. *10 N* R. *3 E*
S. *3* *WP*
3 miles *North* of *SATARTIA*
(distance) (direction) (nearest town)

90

CODED

WELL PURPOSE:

HOME
(home, irrigation, municipal, industrial)


WELL COMPLETION DATA:

- (1) diameter (inches) *2 1/2*
- (2) total depth (feet) *90*
- (3) static water level (feet) *25* below above top of ground.
- (4) casing *Pipe* *8 1/4*
(material) (depth)
(size) if telescope see back.
- (5) screen *4 feet* *9 1/4*
(length) (depth to top)
60 lb. *Brass*
(size) (material)
- (6) pump *3/4* *8*
(HP) (yield gpm)
Clear
(type power)
- (7) electric log *no*
(yes or no)

(organization running log)


(8) how well bottom plugged *Back*
wash valve

DRILLERS REMARKS:

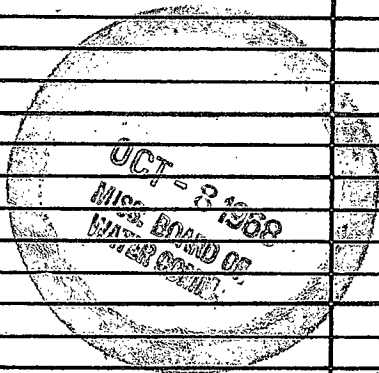

If well telescopes please sketch and show depths.

GROUND LEVEL

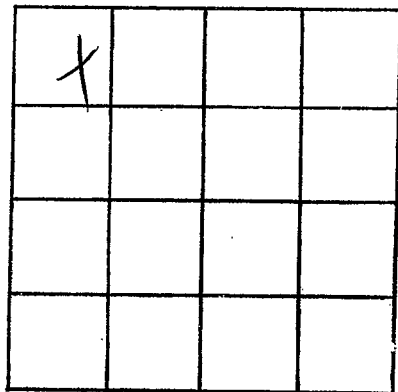

SECTION 20

Please indicate well location X.

ADDITIONAL INFORMATION

If more than one screen,
show locations of each on sketch.

2