

MISSISSIPPI DEPARTMENT OF NATURAL RESOURCES

Bureau of Land and Water Resources

Southport Mall

P.O. Box 10631

Jackson, Mississippi 39209

CODED

WATER WELL DRILLERS LOG

Griner Drilling Service, Inc.

Yazoo
Q28
10-9-81

date well completed

firm name

county well located

10-9-81

Yazoo

LANDOWNER:	description of formations encountered	from	to
<i>Inexco Oil Company</i> <i>633 North Street</i> <i>P.O. Box 22924</i> <i>Jackson, (MS) 39205</i>	<i>Top soil</i>	<i>0</i>	<i>15</i>
WELL LOCATION: <i>1917'N + 1843'W</i>	<i>sand, gravel</i>	<i>15</i>	<i>147</i>
sec <i>4</i> T <i>10</i> R <i>3</i> E SE/40 No. <i>1</i> <i>J.N. Sartarche</i> (distance) miles (direction) of (nearest town) et al			
WELL PURPOSE: <i>oil field supply</i> (home, irrigation, municipal, industrial)			
WELL COMPLETION DATA:			
(1) diameter (inches) <i>4"</i>			
(2) total depth (feet) <i>147'</i>			
(3) static water level (feet) <i>40'</i> <small>below above</small> top of ground.			
(4) casing <i>steel</i> , <i>147'</i> (material), (depth) <i>4"</i> (size) If telescope see back.			
(5) screen <i>42'</i> , <i>105'</i> (length), (depth to top) <i>4"</i> , <i>perforated</i> (size), (material)			
(6) pump <i>—</i> , <i>75</i> (HP), (yield gpm) <i>AC</i> (type power)			
(7) electric log <i>—</i> (yes or no) <i>—</i> (organization running log)			
(8) how well bottom plugged <i>orange</i> <i>peel</i>			
DRILLERS REMARKS:			


CODED

DEPT. OF NATURAL RESOURCES
BUREAU OF LAND & WATER RESOURCES

OCT 20 1981
RECEIVED

If well telescopes please sketch and show depths.

GROUND LEVEL

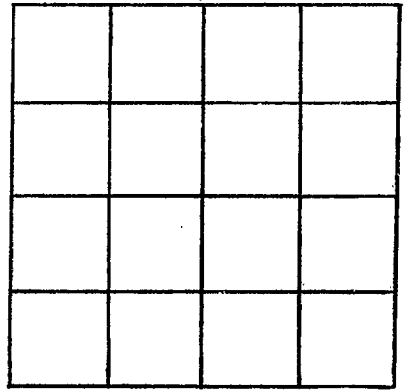

SECTION _____

Please indicate well location X.

ADDITIONAL INFORMATION

If more than one screen, show locations of each on sketch.