

MISSISSIPPI DEPARTMENT OF NATURAL RESOURCES

Bureau of Land and Water Resources

Southport Mall

P.O. Box 10631

Jackson, Mississippi 39209

WATER WELL DRILLERS LOG

CODED

YA 200
Q 48

July 26 1985 E.M. Bud Cresswell YA200
date/well completed firm name county well located

LANDOWNER:
Paul Robinett
SARTARTIA, MS. 39162
(mailing address)

description of formations encountered	from	to
Clay	0	20
Red-graup	20	50
blue clay CODED	50	320
Sandy shale	320	400
bed	400	500

WELL LOCATION:
sec. 29 T 10 N R 3 W
3 miles North of SARTARTIA
(distance) (direction) (nearest town)

WELL PURPOSE: Home
(home, irrigation, municipal, industrial)

WELL COMPLETION DATA:

(1) diameter (inches) 4

(2) total depth (feet) 500

(3) static water level (feet) 30 below top of ground.

(4) casing PVC, 460 (material), (depth)
4 (size) if telescope see back.

(5) screen 40, 460 (length), (depth to top)
2, PVC (size), (material)

(6) pump 1, 20 (HP), (yield gpm)
(type power)

(7) electric log No (yes or no)
(organization running log)

(8) how well bottom plugged
Dark wash


DRILLERS REMARKS:

RECEIVED
AUG 11 1985

Department of Natural Resources
Bureau of Land & Water Resources

If well telescopes please sketch and show depths.

GROUND LEVEL

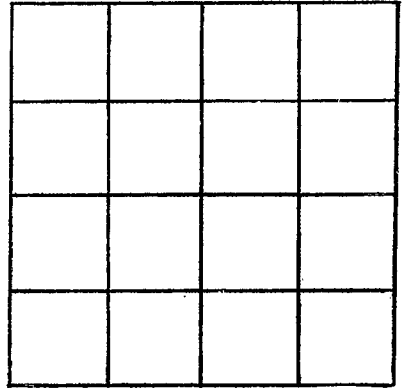

SECTION _____

Please indicate well location X.

ADDITIONAL INFORMATION

If more than one screen, show locations of each on sketch.