

Yazoo
Q. 2001
4/29/76
4/29/76 19

MISSISSIPPI
 BOARD OF WATER COMMISSIONERS
 416 North State Street
 Jackson, Mississippi 39201

WATER WELL DRILLERS LOG

E. M. "Bud" CRESSWELL Yazoo
 firm name county well located

LANDOWNER:

To Lee Smith
 Yazoo City, MS.
 (mailing address)

description of formations encountered

from to

Clay	0	40
Sand	40	55

WELL LOCATION:

sec. 24 T. 8 N. R. 3 W.
2 miles South of Tinsley
 (distance) (direction) (nearest town)

WELL PURPOSE: home
 (home, irrigation, municipal, industrial)

WELL COMPLETION DATA:

- (1) diameter (inches) 2
- (2) total depth (feet) 55
- (3) static water level (feet) 40 below top of ground.
- (4) casing Steel, 50,
 (material) (depth)
2 if telescope see back.
 (size)
- (5) screen 5, 50
 (length) (depth to top)
2, STAINLESS
 (size) (material)
- (6) pump 1, 5
 (HP) (yield gpm)
0
 (type power)
- (7) electric log No
 (yes or no)
0
 (organization running log)

(8) how well bottom plugged

Steel plug


DRILLERS REMARKS

RECEIVED
 MAY 1 1976

MISS. Bd. OF WATER COMMISSIONERS

If well telescopes please sketch and show depths.

GROUND LEVEL

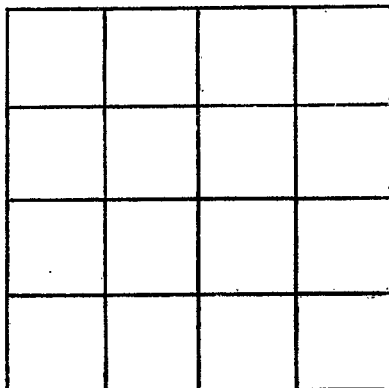

SECTION _____

Please indicate well location X.

ADDITIONAL INFORMATION

If more than one screen,
show locations of each on sketch.