

Yazoo  
 2002  
 9-16-77

MISSISSIPPI  
 BOARD OF WATER COMMISSIONERS  
 416 North State Street  
 15 J Jackson, Mississippi 39201

WATER WELL DRILLERS LOG

9-16 date well completed 19 77 E.M. "Bud" CRESSWELL firm name Yazoo county well located


LANDOWNER:	description of formations encountered	from	to
Charles Ables Yazoo City, MS. (mailing address)			
WELL LOCATION: sec. 30 T 10 N R 3 E 1 miles <del>WEST</del> S of SATARTIA (distance) (direction) (nearest town)			
WELL PURPOSE: FARM (home, irrigation, municipal, industrial)			
WELL COMPLETION DATA:			
(1) diameter (inches) 2			
(2) total depth (feet) 95			
(3) static water level (feet) 20 below top of ground.			
(4) casing PVC 90 (material) (depth) 2 (size) if telescope see back.			
(5) screen 5 90 (length) (depth to top) 2 PVC (size) (material)			
(6) pump None (HP) (yield gpm) 0 (type power)			
(7) electric log No. (yes or no) None (organization running log)			
(8) how well bottom plugged Steel plug			
DRILLERS REMARKS:			

RECEIVED

OCT 17 1977

If well telescopes please sketch and show depths.

GROUND LEVEL

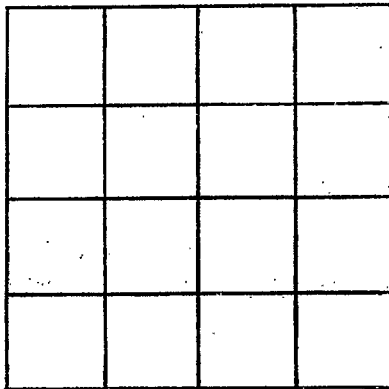

SECTION \_\_\_\_\_

Please indicate well location X.

ADDITIONAL INFORMATION

If more than one screen, show locations of each on sketch.