

MISSISSIPPI DEPARTMENT OF NATURAL RESOURCES

Bureau of Land and Water Resources

Southport Mall

P.O. Box 10631

Jackson, Mississippi 39209

WATER WELL DRILLERS LOG

Yazoo  
Q 2003  
9-16-81

Sept. 16 1981 E.M. "Bud" CRESSWELL YA 200  
 date well completed firm name county well located

LANDOWNER:	description of formations encountered	from	to
<u>Paul Robinette</u>			
<u>SATARTIA MS.</u> (mailing address)	<u>Sand-gravel</u>	<u>30</u>	<u>50</u>

WELL LOCATION:  
 sec 20 T 10 N R 3  
3 miles North of SATARTIA  
 (distance) (direction) (nearest town)

WELL PURPOSE: Home  
 (home, irrigation, municipal, industrial)

WELL COMPLETION DATA:

(1) diameter (inches) 2

(2) total depth (feet) 50

(3) static water level (feet) 30 below above top of ground.

(4) casing PVC 40  
 (material) (depth)  
2 if telescope see back.  
 (size)

(5) screen 10 40  
 (length) (depth to top)  
2 PVC  
 (size) (material)

(6) pump 1 10  
 (HP) (yield gpm)  
 (type power)

(7) electric log no  
 (yes or no)  
 (organization running log)

(8) how well bottom plugged  
Sand shark

DRILLERS REMARKS: \_\_\_\_\_


DEPT. OF NATURAL RESOURCES  
 BUREAU OF LAND & WATER RESOURCES

OCT 13 1981

RECEIVED

If well telescopes please  
sketch and show depths.

GROUND LEVEL

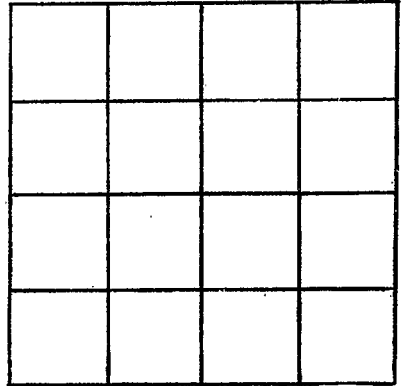

SECTION \_\_\_\_\_

Please indicate well location X.

ADDITIONAL INFORMATION

If more than one screen,  
show locations of each on sketch.