

MISSISSIPPI DEPARTMENT OF NATURAL RESOURCES

Bureau of Land and Water Resources

Southport Mall

P.O. Box 10631

Jackson, Mississippi 39209

WATER WELL DRILLERS LOG

YAWO  
 (S) 2004

Sept. 2

88 E.M. Bud Cresswell YAWO

Date well completed

firm name

county well located

LANDOWNER:	description of formations encountered	from	to
Koch Pipeline			
BENTONIA, MS. (mailing address)	Drilled 6"		
WELL LOCATION: sec 25 T 10 N R 3 2 miles West of City (distance) (direction) (nearest town)	Lolajo Corrosion		
WELL PURPOSE: (home, irrigation, municipal, industrial)	Protection -		
WELL COMPLETION DATA:	Surface	0	30
(1) diameter (inches)	YAWO Clay	30	155
(2) total depth (feet)			
(3) static water level (feet) _____ below above top of ground.			
(4) casing _____ (material) _____ (depth) _____ (size) if telescope see back.			
(5) screen _____ (length) _____ (depth to top) _____ (size) _____ (material)			
(6) pump _____ (HP) _____ (yield gpm) _____ (type power)			
(7) electric log _____ (yes or no) _____ (organization running log)			
(8) how well bottom plugged _____			

RECEIVED


SEP 20 1999

Department of Natural Resources  
 Bureau of Land & Water Resources

DRILLERS REMARKS:

If well telescopes please  
sketch and show depths.

GROUND LEVEL

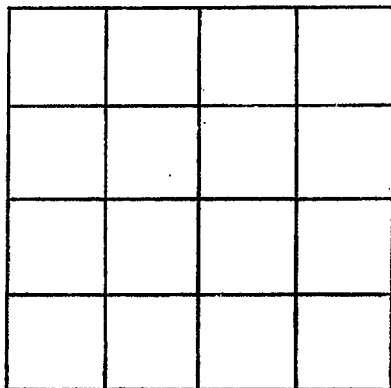

SECTION \_\_\_\_\_

Please indicate well location X.

ADDITIONAL INFORMATION

If more than one screen,  
show locations of each on sketch.