

MISSISSIPPI
BOARD OF WATER COMMISSIONERS
416 North State Street
Jackson, Mississippi 39201

CODED

WATER WELL DRILLERS LOG

Yazoo
R15
6-9-70

6-9 1970 F.M. "Bud" Cresswell Yazoo
date well completed firm name county well located

LANDOWNER:	description of formations encountered	from	to
L.L. Hilton			
Rt. 1 - Bentonia, Miss. (mailing address)	Clay sand-gravel	0 40	40 85
WELL LOCATION:			
sec. 23 T. 10 N R 2			
4 miles North of Bentonia (distance) (direction) (nearest town)			
WELL PURPOSE: 5 hp D (home, irrigation, municipal, industrial)			
WELL COMPLETION DATA:			
(1) diameter (inches) 2			
(2) total depth (feet) 85			
(3) static water level (feet) 70 below above top of ground.			
(4) casing Steel 80 (material) (depth)			
2 If telescope see back. (size)			
(5) screen 5 ft. 80 (length) (depth to top)			
2 Stainless (size) (material)			
(6) pump 3/4 5 est. (HP) (yield gpm)			
0 (type power)			
(7) electric log No (yes or no)			
0 (organization running log)			
(8) how well bottom plugged Steel plug			
DRILLERS REMARKS:			


CODED

JUN 23 1970

MISS. Bd. OF
WATER COMM.

If well telescopes please sketch and show depths.

GROUND LEVEL

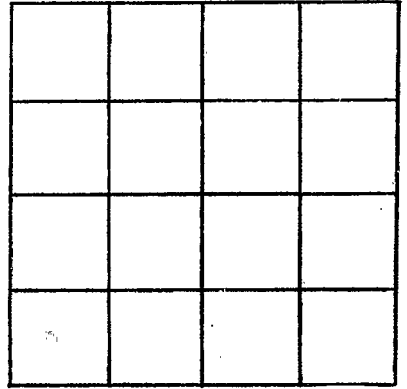

SECTION _____

Please indicate well location X.

ADDITIONAL INFORMATION

If more than one screen,
show locations of each on sketch.