

MISSISSIPPI  
BOARD OF WATER COMMISSIONERS  
416 North State Street  
Jackson, Mississippi 39201

**CODED**

**WATER WELL DRILLERS LOG**

Yazoo  
R16  
6-15-70

6-15 1970 E.M. "Bud" Cresswell Yazoo  
date well completed firm name county well located

LANDOWNER:	description of formations encountered	from	to
<u>E.M. "Bud" CRESSWELL</u> <u>Pt. 2</u> <u>BENTONIA, MISS-</u> (mailing address)			
<b>WELL LOCATION:</b> sec. <u>22</u> T. <u>10</u> N. R. <u>2</u> <u>1</u> miles <u>West</u> of <u>Little Yazoo</u> (distance) (direction) (nearest town)	<u>SAND-gravel</u>	<u>50</u>	<u>70</u>
<b>WELL PURPOSE:</b> <u>None</u> (home, irrigation, municipal, industrial)	<u>YAZOO Clay</u>	<u>70</u>	<u>420</u>
<b>WELL COMPLETION DATA:</b>	<u>Shale</u>	<u>420</u>	<u>700</u>
(1) diameter (inches) <u>2</u>	<u>Sand. streaks Shale</u>	<u>700</u>	<u>840</u>
(2) total depth (feet) <u>840</u>			
(3) static water level (feet) <u>190</u> below above top of ground.			
(4) casing <u>Steel</u> , <u>825</u> (material) (depth)			
<u>2</u> If telescope see back. (size)			
(5) screen <u>15 ft.</u> , <u>825</u> (length) (depth to top)			
<u>2</u> , <u>Stainless</u> (size) (material)			
(6) pump <u>0</u> <u>0</u> (HP) (yield gpm)			
<u>0</u> <u>Air Compressor</u> (type power)			
(7) electric log <u>NO</u> (yes or no)			
(organization running log)			
(8) how well bottom plugged <u>Steel plug</u>			
DRILLERS REMARKS:			


**CODED**

JUN 23 1970

MISS. BD. OF  
WATER COMM.

If well telescopes please sketch and show depths.

GROUND LEVEL

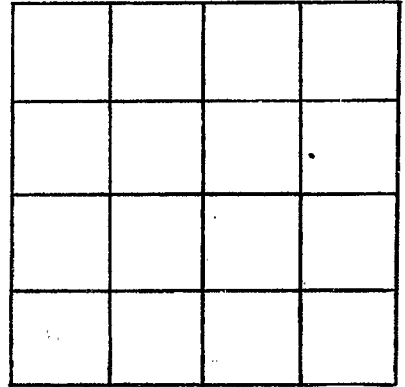

SECTION \_\_\_\_\_

Please indicate well location X.

ADDITIONAL INFORMATION

If more than one screen,  
show locations of each on sketch.