

MISSISSIPPI  
BOARD OF WATER COMMISSIONERS  
416 North State Street  
Jackson, Mississippi 39201

**CODED**

**WATER WELL DRILLERS LOG**

Yazoo  
R17  
6-24-70

June 24 1970 E.M. "Bud" Cresswell Yazoo  
date well completed firm name county well located

**LANDOWNER:**  
W. J. SPIARS  
Rt. 3  
Yazoo City, Miss.  
(mailing address)

description of formations encountered	from	to
Clay	0	35
Sand-gravel	35	68

**WELL LOCATION:**  
sec. 5 T 10 N R 2  
4 miles N of PONTONIA  
(distance) (direction) (nearest town)

**WELL PURPOSE:** DOMESTIC  
(home, irrigation, municipal, industrial)

- WELL COMPLETION DATA:**
- (1) diameter (inches) 2
  - (2) total depth (feet) 68
  - (3) static water level (feet) 50 below top of ground.
  - (4) casing galv. 63  
(material) (depth)  
2 if telescope see back.  
(size)
  - (5) screen 5 63  
(length) (depth to top)  
2 stainless  
(size) (material)
  - (6) pump 3/4 5  
(HP) (yield gpm)  
0  
(type power)
  - (7) electric log no  
(yes or no)  
0  
(organization running log)
  - (8) how well bottom plugged Steel plug

**CODED**


JUL 21 1970

MISS. ST. OF  
WATER COMMISSIONERS

**DRILLERS REMARKS:**

If well telescopes please sketch and show depths.

GROUND LEVEL

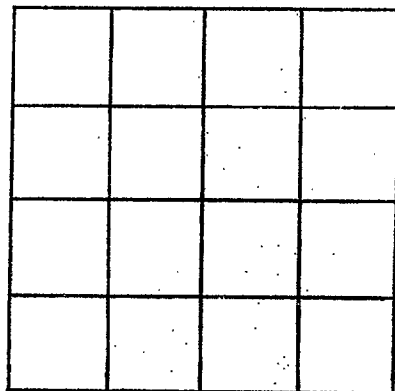

SECTION \_\_\_\_\_

Please indicate well location X.

ADDITIONAL INFORMATION

If more than one screen,  
show locations of each on sketch.