

ELC#179

YAZOO
R 18
10-10-70

MISSISSIPPI
BOARD OF WATER COMMISSIONERS
416 North State Street
Jackson, Mississippi 39201

CODED

WATER WELL DRILLERS LOG

Oct-10 1970 E.M. "Bud" Besswell YAZOO
date well completed firm name county well located

LANDOWNER:
Richard Berry
BENTONIA, Miss.
(mailing address)

description of formations encountered	from	to
Clay - yellow	0	45
Clay - blue	45	320
Shale - blue sand	320	430
Shale - hard	430	570
Sand	570	640

WELL LOCATION:
sec 27 T 10 N R 2 W
at Anding, Miss.
(distance) (direction) (nearest town)

WELL PURPOSE: Domestic
(home, irrigation, municipal, industrial)

- WELL COMPLETION DATA:
- (1) diameter (inches) 2
 - (2) total depth (feet) 640
 - (3) static water level (feet) 160 below top of ground.
 - (4) casing Steel 620 (material) (depth)
2" (size) if telescope see back.
 - (5) screen 20ft. 620ft. (length) (depth to top)
2" (size) stainless (material)
 - (6) pump none 20 (HP) (yield gpm)
0 (type power)
 - (7) electric log 0 (yes or no)
0 (organization running log)

CODED

OCT 22 1970


(8) how well bottom plugged
Steel plug

DRILLERS REMARKS:

ASS. ED. OF
MISSISSIPPI

If well telescopes please
sketch and show depths.

GROUND LEVEL

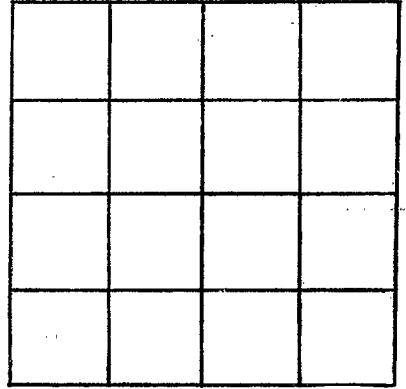

SECTION _____

Please indicate well location X.

ADDITIONAL INFORMATION

If more than one screen,
show locations of each on sketch.