

MISSISSIPPI  
BOARD OF WATER COMMISSIONERS  
416 North State Street  
Jackson, Mississippi 39201

**CODED**

**WATER WELL DRILLERS LOG**

YAZOO  
R 21  
11-2-70

November 2, 1970 F.M. "Bud" Cresswell Yazoo  
date well completed firm name county well located

**LANDOWNER:**

T.C. Kettle

**description of formations encountered**

Clay  
Sand

from

to

0 60  
60 75

BENTONIA, Miss-  
(mailing address)

**WELL LOCATION:**

sec 20 T 10 N R 20 W  
1 miles West of Anding  
(distance) (direction) (nearest town)

**WELL PURPOSE:** Home  
(home, irrigation, municipal, industrial)

**WELL COMPLETION DATA:**

- (1) diameter (inches) 2
- (2) total depth (feet) 75
- (3) static water level (feet) 65 below above top of ground.
- (4) casing 2" Galv. 70 ft.  
(material) (depth)
- (size) if telescope see back.
- (5) screen 5 ft. 70 ft.  
(length) (depth to top)
- 2" stainless  
(size) (material)
- (6) pump 3/4 5  
(HP) (yield gpm)
- 0  
(type power)
- (7) electric log NO  
(yes or no)
- (organization running log)

**CODED**

(8) how well bottom plugged

steel plug


**DRILLERS REMARKS:**

NOV 23 1970

MISS. RD. OF  
WATER COMM.

If well telescopes please sketch and show depths.

GROUND LEVEL

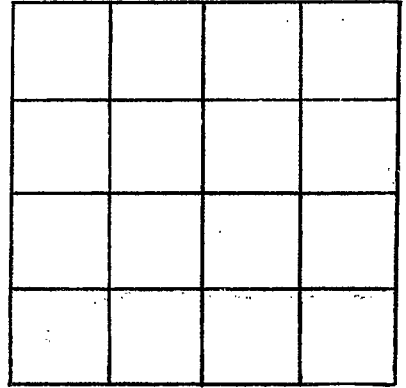

SECTION \_\_\_\_\_

Please indicate well location X.

ADDITIONAL INFORMATION

If more than one screen,  
show locations of each on sketch.