

YAZOO
R23
6-21-71

MISSISSIPPI
BOARD OF WATER COMMISSIONERS
416 North State Street
Jackson, Mississippi 39201

CODED

WATER WELL DRILLERS LOG

June 21 1971 E.M. Bell "Creswell Yazoo"
date well completed firm name county well located

LANDOWNER:
R. Hancock
Benton, Miss.
(mailing address)

description of formations encountered	from	to
Clay	0	60
Blue clay	60	320
Sand - fine	320	520
Sand	520	620

WELL LOCATION:
sec. 26 T 10 N R 2 E
2 miles north of Benton
(distance) (direction) (nearest town)

WELL PURPOSE: Home
(home, irrigation, municipal, industrial)

- WELL COMPLETION DATA:
- (1) diameter (inches) 2
 - (2) total depth (feet) 620
 - (3) static water level (feet) 90 below top of ground.
 - (4) casing Steel 600 (material) (depth)
 - 2 (size) if telescope see back.
 - (5) screen 20 ft. 600 (length) (depth to top)
 - 2" (size) Stainless (material)
 - (6) pump none (HP) (yield gpm)
 - 0 (type power)
 - (7) electric log No (yes or no)
 - (organization running log)

CODED


(8) how well bottom plugged
Steel plug

DRILLERS REMARKS:

MISS. BD. OF WATER COMMISSIONERS

If well telescopes please sketch and show depths.

GROUND LEVEL

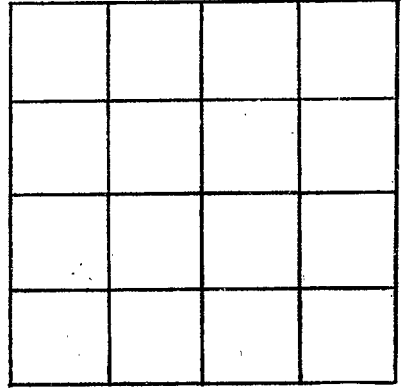

SECTION _____

Please indicate well location X.

ADDITIONAL INFORMATION

If more than one screen, show locations of each on sketch.