

YAZOO
R 27
11-4-71

MISSISSIPPI
 BOARD OF WATER COMMISSIONERS
 416 North State Street
 Jackson, Mississippi 39201

WATER WELL DRILLERS LOG

CODEN
 74200

Nov-4 1971 E.M. "Bud" Cresswell
 date well completed firm name county well located

LANDOWNER:
 Perrin L. Kirk Jr -
 Dentonia, Miss -
 (mailing address)

description of formations encountered	from	to
Clay	0	60
Hard gravel	60	98

WELL LOCATION:
 sec 13 T 10 N R 2
 5 miles North of Dentonia
 (distance) (direction) (nearest town)

WELL PURPOSE: Home
 (home, irrigation, municipal, industrial)

- WELL COMPLETION DATA:
- (1) diameter (inches) 2"
 - (2) total depth (feet) 98
 - (3) static water level (feet) 68 below top of ground.
 - (4) casing Steel 93 (material), (depth)
2" (size) if telescope see back.
 - (5) screen 5ft. 93 (length), (depth to top)
2" (size), stainless (material)
 - (6) pump 3/4 (HP) 5 (yield gpm)
0 (type power)
 - (7) electric log No (yes or no)
0 (organization running log)
 - (8) how well bottom plugged Steel plug

CODEN


DRILLERS REMARKS:

NOV 10 1971

MS 2 57. 68

If well telescopes please
sketch and show depths.

GROUND LEVEL

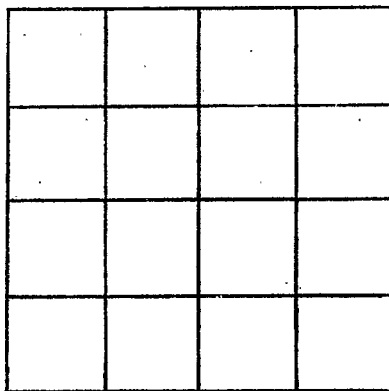

SECTION _____

Please indicate well location X.

ADDITIONAL INFORMATION

If more than one screen,
show locations of each on sketch.