

YAZOO
R30
4-28-72

MISSISSIPPI
BOARD OF WATER COMMISSIONERS
416 North State Street
Jackson, Mississippi 39201

WATER WELL DRILLERS LOG

CODED
YAZOO

April 28 1972 E.M. "Bud" Cresswell
date well completed firm name county well located

LANDOWNER:
Mrs. Lezette Nole
Rt. 3
Yazoo City, Miss.
WELL LOCATION:
sec 2 T 10 N R 2 E
7 miles N of Benton, La.
(distance) (direction) (nearest town)

description of formations encountered	from	to
Clear sand & gravel	0	45
	45	68

WELL PURPOSE: home
(home, irrigation, municipal, industrial)

- WELL COMPLETION DATA:
- (1) diameter (inches) 2
 - (2) total depth (feet) 68
 - (3) static water level (feet) 50 below above top of ground.
 - (4) casing Steel, 63,
(material) (depth)
2 if telescope see back.
(size)
 - (5) screen 5 63
(length) (depth to top)
2 stainless
(size) (material)
 - (6) pump 3/4 5
(HP) (yield gpm)
0
(type power)
 - (7) electric log No
(yes or no)
0
(organization running log)
 - (8) how well bottom plugged Steel plug

CODED


MAY 25 1972

MISS. BU. OF
LAND & WATER

DRILLERS REMARKS:

If well telescopes please sketch and show depths.

GROUND LEVEL

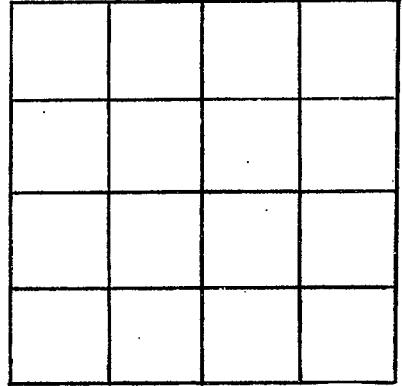

SECTION _____

Please indicate well location X.

ADDITIONAL INFORMATION

If more than one screen,
show locations of each on sketch.