

YAZOO
R 32
5-19-72

MISSISSIPPI
BOARD OF WATER COMMISSIONERS
416 North State Street
Jackson, Mississippi 39201

CODED

WATER WELL DRILLERS LOG

May 19 1972 E.M. "Bud" Gesswell Yazoo
date well completed firm name county well located

LANDOWNER:	description of formations encountered	from	to
LEONARD HENSON Rt. 3 YAZOO CITY, MISS. (drilling address)			
WELL LOCATION: sec <u>2</u> T <u>10</u> N R <u>2</u> <u>7</u> miles <u>N</u> of <u>PENTONSA</u> (distance) (direction) (nearest town)			
WELL PURPOSE: <u>Domestic</u> (home, irrigation, municipal, industrial)			
WELL COMPLETION DATA: (1) diameter (inches) <u>2</u> (2) total depth (feet) <u>68</u> (3) static water level (feet) <u>50</u> below top of ground. (4) casing <u>Steel</u> <u>63</u> (material) (depth) <u>2</u> (size) if telescope see back. (5) screen <u>5</u> <u>63</u> (length) (depth to top) <u>2</u> <u>STAINLESS</u> (size) (material) (6) pump <u>3/4</u> <u>5</u> (HP) (yield gpm) <u>0</u> (type power) (7) electric log <u>No</u> (yes or no) <u>0</u> (organization running log) (8) how well bottom plugged <u>Steel plug</u>			
DRILLERS REMARKS:			


CODED

MAY 25 1972

MISS. BD. OF
WATER COMMISSIONERS

If well telescopes please sketch and show depths.

GROUND LEVEL

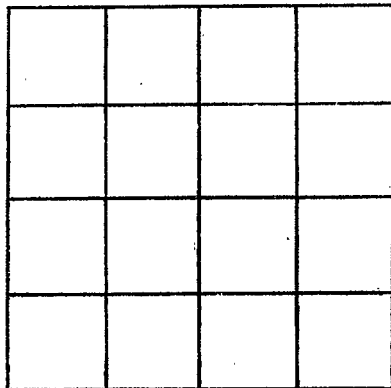

SECTION _____

Please indicate well location X.

ADDITIONAL INFORMATION

If more than one screen,
show locations of each on sketch.