

YAZOO
R 35
10-27-72

MISSISSIPPI
BOARD OF WATER COMMISSIONERS
416 North State Street
Jackson, Mississippi 39201

WATER WELL DRILLERS LOG

INDEXED
YAZOO

Oct. 27 1972
date well completed

E. M. "Bud" Gesswein
firm name

county well located

LANDOWNER:
Terry H. BANKS
BENTONIA, MISS.
(mailing address)

description of formations encountered	from	to
	clay sand & gravel	0 60

WELL LOCATION:
sec. 5 T. 10 N R. 2 E
5 miles N of Bentonia
(distance) (direction) (nearest town)

WELL PURPOSE: Domestic
(home, irrigation, municipal, industrial)

- WELL COMPLETION DATA:
- (1) diameter (inches) 2
 - (2) total depth (feet) 85
 - (3) static water level (feet) 70 below top of ground.
 - (4) casing steel 80
(material) (depth)
2 if telescope see back.
(size)
 - (5) screen 5 80
(length) (depth to top)
2 stainless
(size) (material)
 - (6) pump 3/4 5
(HP) (yield gpm)
0
(type power)
 - (7) electric log 0
(yes or no)
0
(organization running log)

INDEXED


(8) how well bottom plugged
steel plug

DRILLERS REMARKS:

NOV 2 1972
MISS. STATE
WATER BOARD

If well telescopes please sketch and show depths.

GROUND LEVEL

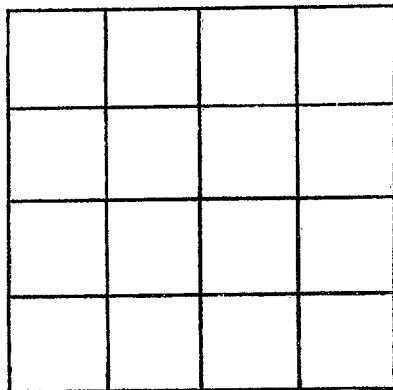

SECTION _____

Please indicate well location X.

ADDITIONAL INFORMATION

If more than one screen,
show locations of each on sketch.