

YAZOO
R 36
11-23-73

MISSISSIPPI
BOARD OF WATER COMMISSIONERS
416 North State Street
Jackson, Mississippi 39201

CODED

WATER WELL DRILLERS LOG

Nov. 23 1973 E. M. "Bud" Cresswell Yazoo
date well completed firm name county well located


LANDOWNER:	description of formations encountered	from	to
Percy Plunkett Yazoo City, Miss. (mailing address)	CLAY SAND-GRAVEL	0 65	65 110
WELL LOCATION: sec. <u>1</u> T. <u>10</u> N. R. <u>2</u> E. W. <u>8</u> 8 miles South of Yazoo City (distance) (direction) (nearest town)			
WELL PURPOSE: <u>home</u> (home, irrigation, municipal, industrial)			
WELL COMPLETION DATA:			
(1) diameter (inches) <u>2</u>			
(2) total depth (feet) <u>110</u>			
(3) static water level (feet) <u>65</u> below above top of ground.			
(4) casing <u>Steel</u> , <u>105</u> (material) (depth) <u>2</u> if telescope see back. (size)			
(5) screen <u>5</u> , <u>105</u> (length) (depth to top) <u>2</u> , <u>STAINLESS</u> (size) (material)			
(6) pump <u>3/4</u> , <u>5</u> (HP) (yield gpm) <u>0</u> (type power)			
(7) electric log <u>No</u> (yes or no)			
<u>0</u> (organization running log)			
(8) how well bottom plugged <u>Steel Plug</u>			
DRILLERS REMARKS:			

CODED

NOV - 2 1973

If well telescopes please
sketch and show depths.

GROUND LEVEL

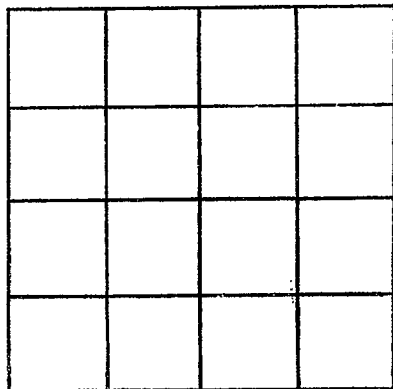

SECTION _____

Please indicate well location X.

ADDITIONAL INFORMATION

If more than one screen,
show locations of each on sketch.