

YAZOO
R 37
10-29-73

MISSISSIPPI
BOARD OF WATER COMMISSIONERS
416 North State Street
Jackson, Mississippi 39201

CODED

WATER WELL DRILLERS LOG

Oct. 29 1973 E.M. "Bud" Cresswell Yazoo
date well completed firm name county well located

LANDOWNER:	description of formations encountered	from	to
JAMES R. HARRIS Yazoo City, Miss. (mailing address)			
	SAND	60	75
	CLAY	75	260
WELL LOCATION:	SAND - sdy shale	260	470
sec. 6 T 10 N R 2 E 7 miles South of Yazoo (distance) (direction) (nearest town)	SAND	470	560
WELL PURPOSE: Home (home, irrigation, municipal, industrial)			
WELL COMPLETION DATA:			
(1) diameter (inches) 2			
(2) total depth (feet) 560			
(3) static water level (feet) 160 below top of ground.			
(4) casing Steel, 540 (material), (depth)			
2 (size) if telescope see back.			
(5) screen 20, 540 (length), (depth to top)			
2, STAINLESS (size), (material)			
(6) pump Air compressor (HP), (yield gpm)			
0 (type power)			
(7) electric log No (yes or no)			
0 (organization running log)			
(8) how well bottom plugged Steel plug			
DRILLERS REMARKS:			


CODED

MISS. REG. NO. 1072
WATER COMM.

MISS. REG. NO.
WATER COMM.

If well telescopes please sketch and show depths.

GROUND LEVEL

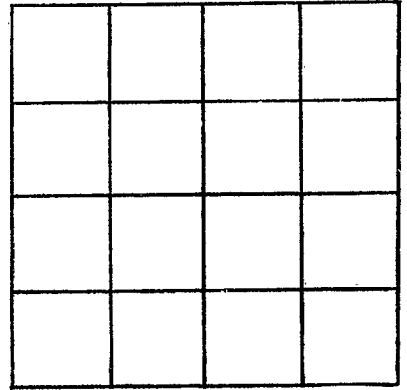

SECTION _____

Please indicate well location X.

ADDITIONAL INFORMATION

If more than one screen,
show locations of each on sketch.