

YAZOO  
R 38  
4-22-74

MISSISSIPPI  
BOARD OF WATER COMMISSIONERS  
416 North State Street  
Jackson, Mississippi 39201  
**CODED**

WATER WELL DRILLERS LOG

April 22 1974 F.M. "Bud" Cresswell Yazoo  
date well completed firm name county well located

LANDOWNER:	description of formations encountered	from	to
Tommy Twinedel Benton, Miss. (mailing address)			
WELL LOCATION: sec 31 T 10 N R 2 E 5 miles West Benton (distance) (direction) (nearest town)			
WELL PURPOSE: Home (home, irrigation, municipal, industrial)			
WELL COMPLETION DATA:			
(1) diameter (inches) 2			
(2) total depth (feet) 105			
(3) static water level (feet) 85 below top of ground.			
(4) casing steel 100 (material) (depth)			
2 if telescope see back. (size)			
(5) screen 5 100 (length) (depth to top)			
2 stainless (size) (material)			
(6) pump 3/4 4 (HP) (yield gpm)			
0 (type power)			
(7) electric log 0 (yes or no)			
0 (organization running log)			
(8) how well bottom plugged Red plug			
DRILLERS REMARKS:			


CODED

RECEIVED  
MAY 21 1974

MISS. BD. OF WATER COMMISSIONERS

If well telescopes please sketch and show depths.

GROUND LEVEL

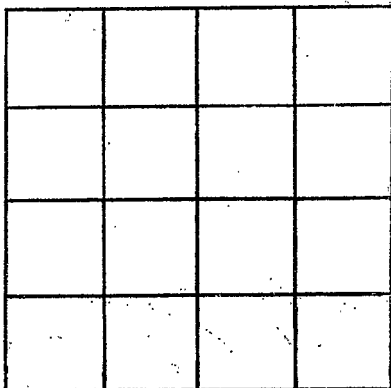

SECTION \_\_\_\_\_

Please indicate well location X.

ADDITIONAL INFORMATION

If more than one screen, show locations of each on sketch.