

YAZOO
K 39
1-31-75

MISSISSIPPI
BOARD OF WATER COMMISSIONERS
416 North State Street
Jackson, Mississippi 39201 **CODED**

WATER WELL DRILLERS LOG

Jan 31 1975 E.M. "Bud" CRESSWELL YAZOO
date well completed firm name county well located

LANDOWNER:
Arthur Spiars
Yazoo City, Miss.
(mailing address)

WELL LOCATION:
sec. 7 T 10 N R 2 E
W
2 miles E of Tinsley
(distance) (direction) (nearest town)

description of formations encountered	from	to
<u>Clay</u>	<u>0</u>	<u>190</u>
<u>Sand</u>	<u>190</u>	<u>220</u>
<u>Clay</u>	<u>220</u>	<u>250</u>
<u>Sand</u>	<u>250</u>	<u>383</u>

WELL PURPOSE: Home
(home, irrigation, municipal, industrial)

WELL COMPLETION DATA:

(1) diameter (inches) 2

(2) total depth (feet) 383

(3) static water level (feet) 80 below above top of ground.

(4) casing Steel, 373,
(material) (depth)
2 if telescope see back.
(size)

(5) screen 10, 373
(length) (depth to top)
2, Stainless
(size) (material)

(6) pump 1, 5
(HP) (yield gpm)
0
(type power)

(7) electric log No
(yes or no)
0
(organization running log)


(8) how well bottom plugged
Steel plug

RECEIVED
FEB 6 - 1975

DRILLERS REMARKS:

If well telescopes please
sketch and show depths.

GROUND LEVEL

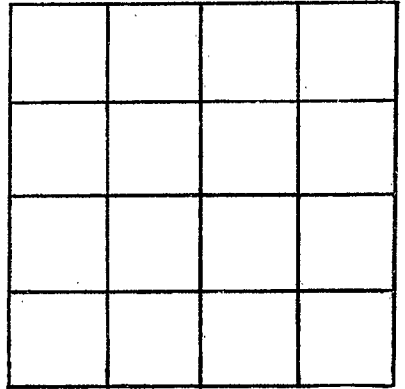

SECTION _____

Please indicate well location X.

ADDITIONAL INFORMATION

If more than one screen,
show locations of each on sketch.