

VA200  
R 40  
3-10-75

MISSISSIPPI  
 BOARD OF WATER COMMISSIONERS  
 416 North State Street  
 Jackson, Mississippi 39201

CODED

WATER WELL DRILLERS LOG

March 10 1975 E.M. "Bud" Cresswell VA200  
 date well completed firm name county well located

LANDOWNER:	description of formations encountered	from	to
BENTONIA PENTECOSTAL Church of God Rt. 2, Benton, Ms. (mailing address)			
<b>WELL LOCATION:</b> sec <u>23</u> T <u>10</u> N R <u>2</u> E <u>3</u> miles North Benton (distance) (direction) (nearest town)			
<b>WELL PURPOSE:</b> Home (home, irrigation, municipal, industrial)			
<b>WELL COMPLETION DATA:</b> (1) diameter (inches) <u>2</u> (2) total depth (feet) <u>68</u> (3) static water level (feet) <u>55</u> below top of ground. (4) casing <u>Steel</u> <u>63</u> (material) (depth) <u>2</u> If telescope see back. (size) (5) screen <u>5</u> <u>63</u> (length) (depth to top) <u>2</u> <u>Stainless</u> (size) (material) (6) pump <u>3/4</u> <u>5</u> (HP) (yield gpm) <u>0</u> (type power) (7) electric log <u>No</u> (organization running log)			
(8) how well bottom plugged <u>Steel plug</u>			
<b>DRILLERS REMARKS:</b>			


CODED

DEC  
 1975

APR - 9 1975

If well telescopes please  
sketch and show depths.

GROUND LEVEL

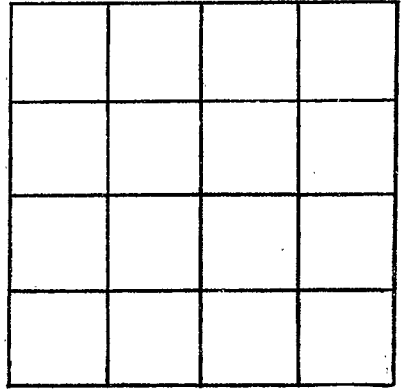

SECTION \_\_\_\_\_

Please indicate well location X.

ADDITIONAL INFORMATION

If more than one screen,  
show locations of each on sketch.