

YAZOO

~~Madison~~
R41 Ely 267
2-23-76
15K

MISSISSIPPI
BOARD OF WATER COMMISSIONERS
416 North State Street
Jackson, Mississippi 39201

CODED

YAZOO

WATER WELL DRILLERS LOG

MADISON

2/23
date well completed

76 E.M. "Bud" CRESSWELL
firm name

YAZOO
county well located

LANDOWNER:
Willie Mae Jordan
Benton, Mo.
(mailing address)

description of formations encountered	depth	
	from	to
Clay	0	60
Sandy gravel	60	125
Clay	125	320
sand - shells	320	350
Shell	350	660

WELL LOCATION:
sec. 31 T. 10 N R. 2 W
1 miles S of City
(distance) (direction) (nearest town)

WELL PURPOSE:
(home, irrigation, municipal, industrial)

CODED

WELL COMPLETION DATA:

(1) diameter (inches) 4

(2) total depth (feet) 660

(3) static water level (feet) 210 below top of ground.

(4) casing Steel; 640 (material) (depth)
4 (size) If telescope see back.

(5) screen 20, 640 (length) (depth to top)
2, Stainless (size) (material)

(6) pump 1, 10 (HP) (yield gpm)
0 (type power)

(7) electric log yes (yes or no)
USGS (organization running log)

(8) how well bottom plugged
plugged


DRILLERS REMARKS:

RECEIVED

FEB 24 1976

If well telescopes please sketch and show depths.

GROUND LEVEL

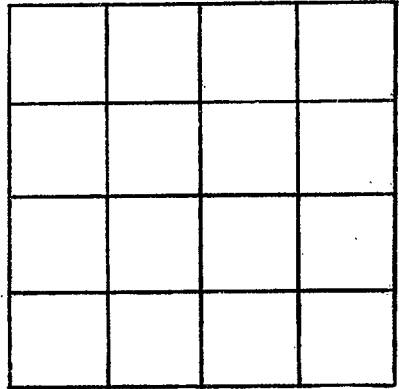

SECTION _____

Please indicate well location X.

ADDITIONAL INFORMATION

If more than one screen, show locations of each on sketch.