

MISSISSIPPI DEPARTMENT OF NATURAL RESOURCES

Bureau of Land and Water Resources

Southport Mall

P.O. Box 10631

Jackson, Mississippi 39209

WATER WELL DRILLERS LOG

**CODED**

Yazoo  
R042  
4-3-81

April 3 1981  
 date well completed

81 E.M. "Bud" Cresswell Yazoo  
 firm name

county well located

140 S 2080 W 2080

LANDOWNER:  
Phillips Petroleum Co.  
Houston, Texas 77001  
 (mailing address)

description of formations encountered	from	to
<u>Clay</u>	<u>0</u>	<u>40</u>
<u>Sand - gravel</u>	<u>40</u>	<u>100</u>
<u>Clay</u>	<u>100</u>	<u>340</u>
<u>Sand - shale</u>	<u>340</u>	<u>600</u>
<u>Sand</u>	<u>600</u>	<u>650</u>


WELL LOCATION:  
 sec. 24 T. 10 N. R. 2 E.  
1 miles EAST of Little Yazoo  
 (distance) (direction) (nearest town)

WELL PURPOSE: Industrial  
 (home, irrigation, municipal, industrial)

- WELL COMPLETION DATA:
- (1) diameter (inches) 6
  - (2) total depth (feet) 650
  - (3) static water level (feet) 220 below above top of ground.
  - (4) casing steel 610  
 (material) (depth)  
6 if telescope see back.  
 (size)
  - (5) screen 40 610  
 (length) (depth to top)  
4 STAINLESS  
 (size) (material)
  - (6) pump 15 100  
 (HP) (yield gpm)  
 (type power)
  - (7) electric log NO  
 (yes or no)
- (organization running log)

how well bottom plugged:  
dark wash valve

DRILLERS REMARKS:

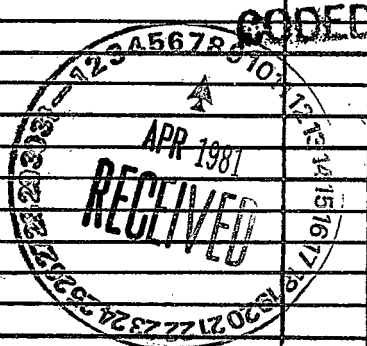

DEPT. OF NATURAL RESOURCES  
 BUREAU OF LAND & WATER RESOURCES

APR - 8 1981

**RECEIVED**

If well telescopes please sketch and show depths.

GROUND LEVEL

CODED  
CODED

CODED


SECTION \_\_\_\_\_

Please indicate well location X.

ADDITIONAL INFORMATION

If more than one screen,  
show locations of each on sketch.