

Y4200
R 44
4/1/83

MISSISSIPPI
BOARD OF WATER COMMISSIONERS
416 North State Street
Jackson, Mississippi 39201

WATER WELL DRILLERS LOG

April 1 1983 E.M. "Bud" CRESSWELL Y4200
date well completed firm name county well located

LANDOWNER:
McGowan-Rebel Drilling Co.
Natchez, Ms.
(mailing address)

description of formations encountered	from	to
Clay	0	65
Sand & gravel	65	95
Clay	95	310
Sandy shale	310	450
Sand	450	530

WELL LOCATION:
sec. 30 T. 10 N R. 2 E
at Oil City, Ms.
(distance) miles (direction) of (nearest town)

WELL PURPOSE: Industrial
(home, irrigation, municipal, industrial)

WELL COMPLETION DATA:

(1) diameter (inches) 3

(2) total depth (feet) 530

(3) static water level (feet) 210 below top of ground.

(4) casing Steel, 510 (material) (depth)
3 if telescope see back. (size)

(5) screen 20, 510 (length) (depth to top)
3" Stainless (size) (material)

(6) pump Air-Lamp 30 (HP) (yield gpm)

(type power)

(7) electric log No (yes or no)

(organization running log)

(8) how well bottom plugged
SAND SHARK


DRILLERS REMARKS:

CODED

DEPT. OF NATURAL RESOURCES
BUREAU OF LAND & WATER RESOURCES
APR 11 1983
RECEIVED

If well telescopes please sketch and show depths.

GROUND LEVEL

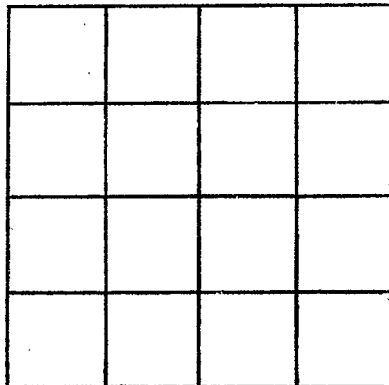

SECTION _____

Please indicate well location X.

ADDITIONAL INFORMATION

If more than one screen, show locations of each on sketch.