

MISSISSIPPI DEPARTMENT OF NATURAL RESOURCES

Bureau of Land and Water Resources

Southport Mall

P.O. Box 10631

Jackson, Mississippi 39209

WATER WELL DRILLERS LOG

CODED

YAZOO
R 45
MAY 23
date well completed

86 E.M. Bud CRESSWELL
firm name

YAZOO
county well located

LANDOWNER:
MR. Kerry Briggs
JACKSON, MS.
(mailing address)

description of formations encountered	from	to
surface	0	60
blue clay	60	420
shale	420	520
Band	520	620

WELL LOCATION:
sec. 4 T 10 N R 2 W
3 miles EAST of Tinsley
(distance) (direction) (nearest town)

WELL PURPOSE: farm
(home, irrigation, municipal, industrial)

- WELL COMPLETION DATA:
- (1) diameter (inches) 4
 - (2) total depth (feet) 620
 - (3) static water level (feet) 200 below top of ground.
 - (4) casing PVC 560 (material) (depth)
 - 4 (size) if telescope see back.
 - (5) screen 60 560 (length) (depth to top)
 - 4 PVC (size) (material)
 - (6) pump 5 50 (HP) (yield gpm)
 - (type power)
 - (7) electric log no (yes or no)
 - (organization running log)
 - (8) No, well bottom plugged

CODED


RECEIVED
MAY 28 1986

DRILLERS REMARKS:

Department of Natural Resources
Bureau of Land & Water Resources

If well telescopes please sketch and show depths.

GROUND LEVEL

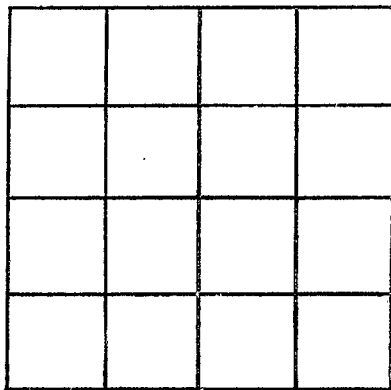

SECTION _____

Please indicate well location X.

ADDITIONAL INFORMATION

If more than one screen,
show locations of each on sketch.