

MISSISSIPPI DEPARTMENT OF NATURAL RESOURCES

Bureau of Land and Water Resources

Southport Mall

P.O. Box 10631

Jackson, Mississippi 39209

WATER WELL DRILLERS LOG

CODED

Y4200
R 46

Aug. 19 1986
date well completed

E. M. Bud Cresswell
firm name

Y4200
county well located

LANDOWNER:
Billy GRAHAM
BENTONIA, MS. 39004
(mailing address)

description of formations encountered

from to

Surface - 0 45
sand - gravel 45-95

WELL LOCATION:
sec. 23 T. 10 N. R. 2 W.
5 miles North of Bentonia
(distance) (direction) (nearest town)

CODED

WELL PURPOSE: Home
(home, irrigation, municipal, industrial)

WELL COMPLETION DATA:

(1) diameter (inches) 4

(2) total depth (feet) 95

(3) static water level (feet) 70 below top of ground.

(4) casing PVC 75
(material) (depth)
4 If telescope see back.
(size)

(5) screen 10 75
(length) (depth to top)
4 PVC
(size) (material)

(6) pump 1/2 10
(HP) (yield gpm)

(type power)

(7) electric log No
(yes or no)

(organization running log)

(8) how well bottom plugged
Back Wash

RECEIVED


AUG 26 1986

Department of Natural Resources
Bureau of Land & Water Resources

DRILLERS REMARKS:

If well telescopes please sketch and show depths.

GROUND LEVEL

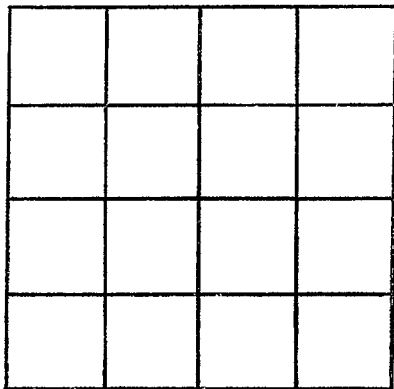

SECTION _____

Please indicate well location X.

ADDITIONAL INFORMATION

If more than one screen,
show locations of each on sketch.