

MISSISSIPPI DEPARTMENT OF NATURAL RESOURCES

Bureau of Land and Water Resources

Southport Mall

P.O. Box 10631

Jackson, Mississippi 39209


WATER WELL DRILLERS LOG

Yazoo
R47
6-27-88

Coded

June 27 1988 E.M. Bud Cresswell Yazoo
date well completed firm name county well located


LANDOWNER:	description of formations encountered	from	to
Lee BRANNUM			
Yazoo City, MS. (mailing address)	Surface	0	35
	Sand-gravel	35	65
	Yazoo Clay	65	230
	Meridian Branch	230	250
	Shale with sand	250	545
	Sand	545	635
WELL LOCATION:			
sec. 17 T 10 N R 2 E W			
10 miles South of Yazoo (distance) (direction) (nearest town)			
WELL PURPOSE: None (home, irrigation, municipal, industrial)			
WELL COMPLETION DATA:			
(1) diameter (inches) 4			
(2) total depth (feet) 635			
(3) static water level (feet) 160 below top of ground.			
(4) casing PVC 605 (material) (depth)			
4 (size) if telescope see back.			
(5) screen 30 605 (length) (depth to top)			
4 PVC (size) (material)			
(6) pump 1 12 (HP) (yield gpm)			
(type power)			
(7) electric log yes (yes or no)			
State (organization running log)			
(8) how well bottom plugged Sand pack			
DRILLERS REMARKS:			

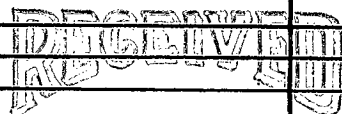

Department of Natural Resources
Bureau of Land & Water Resources

If well telescopes please sketch and show depths.

GROUND LEVEL

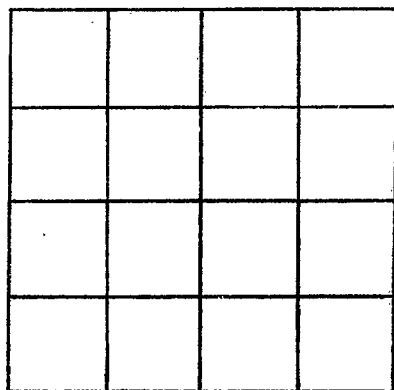

SECTION _____

Please indicate well location X.

ADDITIONAL INFORMATION

If more than one screen,
show locations of each on sketch.