

YAZOO

R 53

10-10-62

WATER WELL DRILLERS LOG

Date Oct 10, 1962, Driller: BUD CRESSEWELL County YAZOO
(Name)

(1) Owner of Land: O.C. BURAS
(Name)
BENTONIA HIGHWAY 49
(Address)

(2) Location: 3 north miles, of Bentonia
(distance) (direction) (Nearest Town)

(3) Topography: Hilly
(Hilly) (Flat) (Level)

(4) Purpose of Well: DOMESTIC
(Domestic Irrigation
Municipal, Industrial, Other)

Description & Color of Materials Sand, Clay, Red Clay, Shell, etc.	Thick- ness Feet	Depth Feet
<u>YELLOW CLAY</u>	<u>40</u>	<u>40</u>
<u>Gravel and GRAVEL</u>	<u>25</u>	<u>65</u>

Information upon completion of well:

(1) Diameter 2" inches.

(2) Total Depth 65 feet.


(3) Water Level 40 feet below top of ground.

(4) Cased to 60, Size _____.

(5) Screen: Size 2", Length 5'.

(6) Were any formations sealed against pollution?
_____ yes, no.

If YES depth of formation _____
Why _____
Drillers Remarks: _____

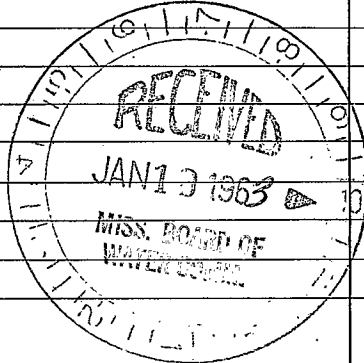

(Use Back Side)

Well No.

