

YA200

R 54

WATER WELL DRILLERS LOG

Date: 2-3-63 1963, Driller: BOB GRESSWELL County YA200
(Name)

(1) Owner of Land: Will Peterman
(Name)
YA200 City
(Address)

(2) Location: 1/4, 1/4, Sec. T R ,
2 miles East of LITTLE
(distance) (direction) (Nearest Town)

(3) Topography: Flat
(Hilly) (Flat) (Level)

(4) Purpose of Well: Domestic
(Domestic Irrigation
Municipal, Industrial, Other)

Description & Color of Materials Sand, Clay, Red Clay, Shell, etc.	Thick- ness Feet	Depth Feet
Red Clay	10	10
Blue Clay	200	210
Greenish Sand	60	270
Grey Shale	16	286
Grey Sand	110	396
Grey Shale	20	416
Grey Sand	90	506
Water Shale	570	1076
Shale Sand Rock	50	1126
Sand	30	1156
Sand and Shale	30	1186
Sand	30	1216
For Shale	40	1256

Information upon completion of well:

(1) Diameter 4" 00" inches.
1 1/2

(2) Total Depth 1350 feet.

(3) Water Level 100 feet below top of ground.

(4) Cased to 1200, Size 2 1/2


(5) Screen: Size 2" 00", Length 30

(6) Were any formations sealed against pollution?
 yes, no.

If YES depth of formation

Why

Drillers Remarks: 2 1/2" 50 ft pump

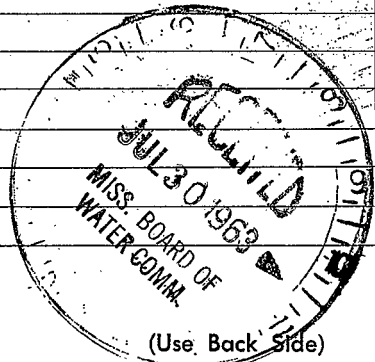

Well No.

100