

YA200
R 55
5-18-63

WATER WELL DRILLERS LOG

Date: 5-18-63, 19 63 Driller: CRELL CREFFEL County: Madison
(Name)

(1) Owner of Land: H. F. D. L. O. L.
(Name)
BEATON, MISS.
(Address)

(2) Location: 1/4, 1/4, Sec. T. R.
 miles of
(distance) (direction) (Nearest Town)

(3) Topography: Hilly
(Hilly) (Flat) (Level)

(4) Purpose of Well: DOMESTIC
(Domestic Irrigation
Municipal, Industrial, Other)

Information upon completion of well:


- (1) Diameter: 2 inches.
- (2) Total Depth: 89 feet.
- (3) Water Level: 60 feet below top of ground.
- (4) Cased to 84', Size 2
- (5) Screen: Size 2, Length 5'
- (6) Were any formations sealed against pollution?
 yes, no.

If YES depth of formation

Why

Drillers Remarks:

Description & Color of Materials Sand, Clay, Red Clay, Shell, etc.	Thick- ness Feet	Depth Feet
<u>SURFACE CLAY</u>	<u>40</u>	<u>00</u>
<u>SAND & GRAVEL</u>	<u>49</u>	<u>89</u>

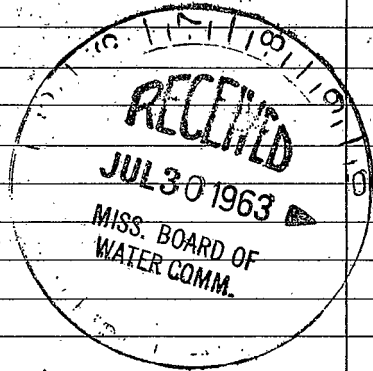

(Use Back Side)

Well No.

